



Sec. 17 Twp. 17 R. 3W

Well No. #1 Community "E" Farm

Bay Pet. Company

Lindsborg


           Ft. from N. Line

990 Ft. from S. Line

           Ft. from E. Line

990 Ft. from W. Line

NE SW NW

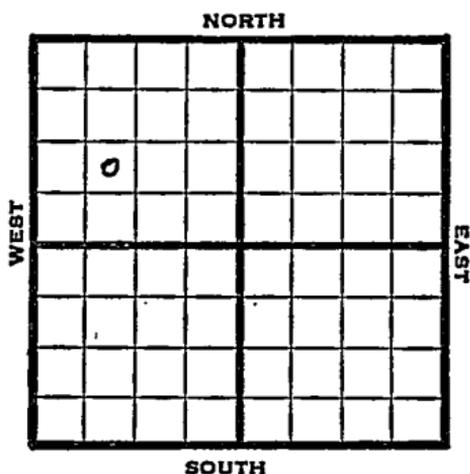

1947	Elev. 1341' REPORT
7/23	Location
7/29	12" @ 164' 8" @ 366' Drlg. 1960'
8/6	Viola 3381' TD 3386' 5" @ 3382' RUST
8/13	"
8/20	TD 3400' 500 acid 400' oil
8/27	"
9/3	"
9/10	"
9/17	"
9/24	Viola 3381' 5" @ 3382' 500 acid Pump 15 Pot 36.0 Gr. TD 3400'

COMPLETED

Map No.                      Sec. 17 Twp. 17 R. 3W

Well No. 1 Community "E"

Bay Pet. Company                     

## FIRST REPORT

Contractor                     

NE SW NW

## SECTION PLAT

                     Ft. from N. Line990 Ft. from S. Line                     Ft. from E. Line990 Ft. from W. Line

16			

McPherson CountyLocation                      XRig up                     

Drilling and Remarks:

## RECORD

Cased                      in,                      ft.Sand                     Gas                     Oil                     Total Depth                     

## PRODUCTION

1st 24 hrs. Nat.                     1st 24 hrs. after shot                     Gas                      Cu. Ft.Dry Hole                     Abandoned                     

Date

JUL 23 194719S. J. LEWIS

Scout

