


Section 18 Township 17 Range 9-W

Well No. #2 Jansen

Company Hollow Drilling

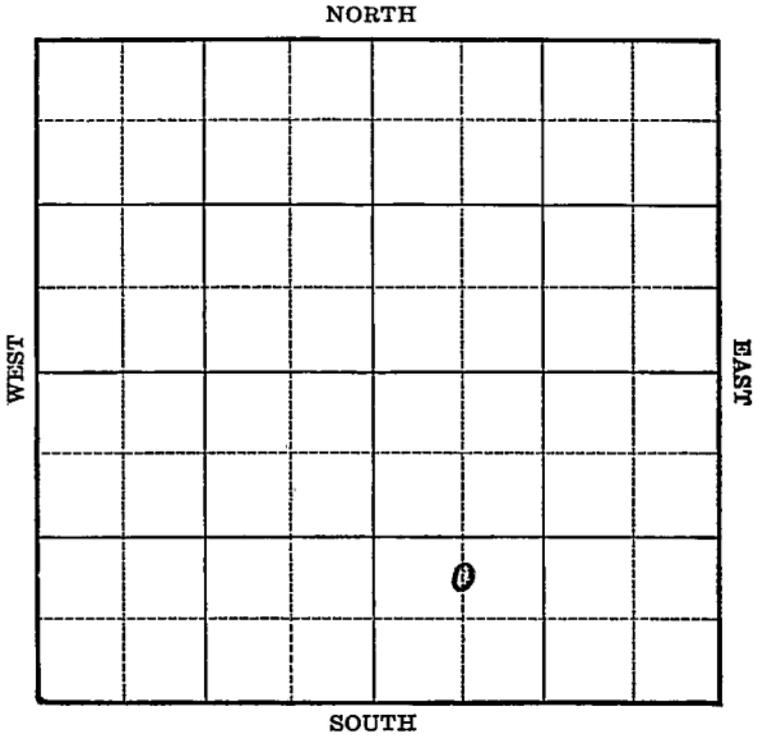

Sec. 18 Twp. 17 R. 9-W

Well No. #2 Jansen Farm

Hollow Drilling Company
(Schroeder)


 Ft. from N. Line

99.0 Ft. from S. Line

 Ft. from E. Line

66.0 Ft. from W. Line

Elev. 1788

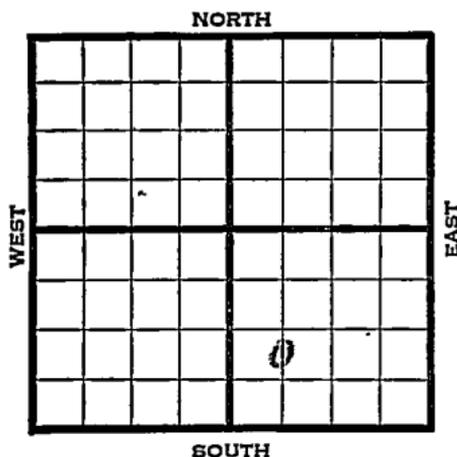

1941

REPORT

2/12

Location

2/20

8" - 224' Anhy 505'

Drilg. 1755'

2/27

Lens. 2924' Arb. 3251-55' T.D.

Run casing.

3/6

5" - 3252' 2300' oil 1 hour.

3/13

20.00 acid. Pump 200 bbls. in 14 hours.

3/20

" "

3/27

" "

4/2

800 acid.

4/10

"

4/18

"

4/24

"

5/1

T.D. 3259 1/2' Swab 23 1/2 bbls. per hour 3 hours.

5/8

Shut down.

5/15

" "

5/22

" "

5/28

" "

OVER

1941

6/4

Arb. 3251'

5" - 3252'

T.D. 3256'

1000 aci d.

Dep thograph potential 2400 bbls.

40.5 Gravity

COMPLETED

Map No. 45 Sec. 18 Twp. 17 R. 9WWell No. 2 Jansen

Hollow Drilling _____ Company

FIRST REPORT

Contractor _____

C N L SW SE

SECTION PLAT

		o	

_____ Ft. from N. Line

990 Ft. from S. Line

_____ Ft. from E. Line

660 Ft. from W. Line

SCHROEDER POOL

Location X

Rig up _____

Drilling and Remarks:

RECORD

Cased _____ in., _____ ft.

Sand _____

Gas _____

Oil _____

Total Depth _____

PRODUCTION

1st 24 hrs.-Nat. _____

1st 24 hrs. after shot _____

Gas _____ Cu. Ft.

Dry Hole _____

Abandoned _____

Date

FEB 12 1941

19

S I I FWIS Scout

Misc. Small Maps	<i>[Handwritten mark]</i>
Cards	<i>[Handwritten mark]</i>
Tracing	<i>[Handwritten mark]</i>

Map No. 45 Sec. 18 Twp. 17 R. 9W

Well No. 2 Janzen

Hollow Drilling Company

Contractor

COMPLETED

C N L SW SE

SECTION PLAT

 Ft. from N. Line

990 Ft. from S. Line

 Ft. from E. Line

660 Ft. from W. Line

SCHROEDER POOL

Location

Rig up

Drilling and Remarks:

*Cor Y3251
5" @ 3252.
1000 acid
Depth 3256*

405

RECORD

Cased in., ft.

Sand

Gas

Oil

Total Depth 3256

PRODUCTION

1st 24 hrs. Nat.

1st 24 hrs. after shot

Gas Cu. Ft.

Dry Hole 1-1

Abandoned

Date

JUN 4 1941
19

S. J. LEWIS Scout

Misc. Small Maps
Cards
Tracing
France Map
Scarborough Map
Moody Map
Geological Dept.
Moody Plat Book

RAY
Grove
RAY
Grove