

KANSAS

Form 51-5M-7-39-Palace


Ellsworth

Section 18 Township 17 Range 9-W

Well No. #1 Janzen

Company Hollow Drilling

NORTH Wilkins Pool

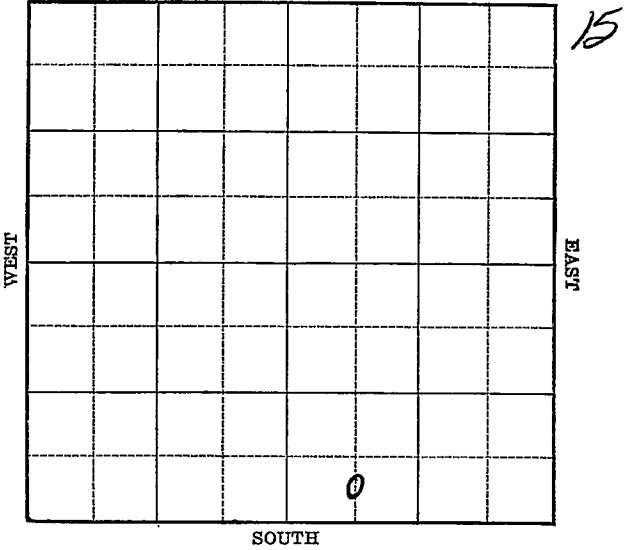

Sec. 18 Twp. 17 R. 9-W

Well No. #1 Janzen Farm

Hollow Drilling Company

(Wilkins)


_____ Ft. from N. Line

330 Ft. from S. Line

_____ Ft. from E. Line

660 Ft. from W. Line

Elev. 1788

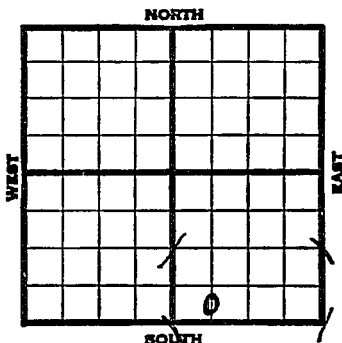

1940	REPORT
1/31	S. H.
2/8	8" - 202' Anhy 500' Drig. 1895'
2/15	Topeka 2575' Lans. 2924' S.O. 3008-10' Drig. 3213'
2/23	Arb. 3251' 5" - 3251' T.D. 3259' SO. RUST.
2/29	Drilled plug. H.F.O. 1000 acid. No test.
3/6	Arb. 3251' 5" - 3251'
	T.D. 3259' 1000 acid.
	Echometer potential 7070 bbls. Maximum 3000 bbls.
	COMPLETED

Map No. 45 Sec. 18 Twp. 17 R. 9W

Well No. 1 Janzen

Hollow Drilling Company

Contractor

FIRST REPORT

C S L SW SE

SECTION PLAT

		o	

_____ Ft. from N. Line

330 Ft. from S. Line

_____ Ft. from E. Line

660 Ft. from W. Line

WILKINS POOL

Location _____

Rig up _____

Drilling and Remarks:

S. H.

RECORD

Cased _____ in., _____ ft.

Sand _____

Gas _____

Oil _____

Total Depth _____

PRODUCTION

1st 24 hrs. Nat. _____

1st 24 hrs. after shot _____

Gas _____ Cu. Ft.

Dry Hole _____

Abandoned _____

Date

JAN 31 1940 19____

S. J. LEWIS Scout

1881
1882
1883

Misc. Small Maps	RAY
Cards	RAY
Tracing	RAY
France Map	RAY
Scarborough Map	RAY
Moody Map	RAY
Geological Dept.	
Moody Flat Book	

Map No. 45 Sec. 18 Twp. 17 R. 9W

Well No. 1 Janzen

Hollow Drilling Company

Contractor

COMPLETED

SECTION PLAT

C S L SW SE

_____ Ft. from N. Line

330 Ft. from S. Line

_____ Ft. from E. Line

660 Ft. from W. Line

WILKINS POOL

		0	

Location _____

Rig up _____

Drilling and Remarks:

1000 acid
5" C 3251
Echometer potential
7070 bbls
Maximum pot.
3000 bbls

RECORD

Cased _____ in., _____ ft.

Sand *2 1/2* 3251

Gas _____

Oil _____

Total Depth 3259

PRODUCTION

1st 24 hrs. Nat. _____

1st 24 hrs. after shot _____

Gas _____ Cu. Ft.

Dry Hole _____

Abandoned _____

Date

MAR 6 1940 19

S. J. LEWIS

Scout

U. 11314

1. 1/2 1/2

2007

U. 1. 150 170

Misc. Small Maps	<i>RAM</i>
Cards	<i>RAM</i>
Tracing	<i>RAM</i>
France Map	<i>RAM</i>
Scarborough Map	<i>RAM</i>
Moody Map	<i>RAM</i>
Geological Dept.	
Moody Flat Book	