


Section 18 Township 17 Range 9W

Well No. 1 Janzen

Company B & R Drlg

Stoltenberg
NORTH

9

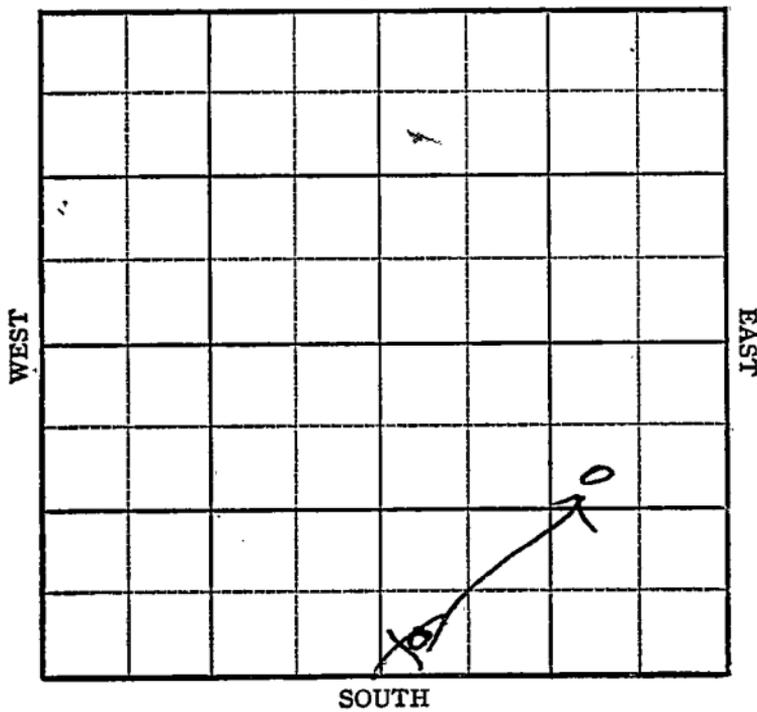

SOUTH

Sec. 18 Twp. 17 R. 9W ✓

Well No. #1 Janzen Farm

B & R Drlg. Company


Stoltenberg Pool

990' Ft. from N. Line

~~550'~~ Ft. from S. Line

990' Ft. from E. Line

~~330'~~ Ft. from W. Line

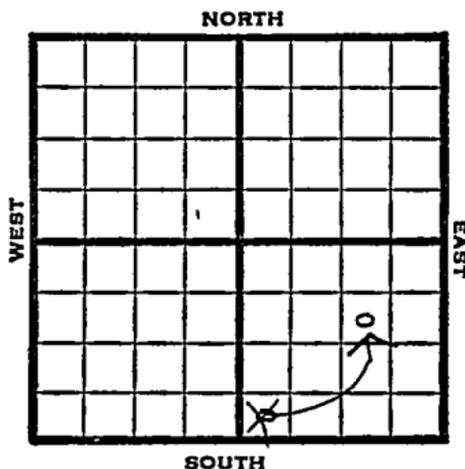

SW SE NE SE

1949 Elev 1780' REPORT

1/19	RUR
1/26	8" @ 176'
	Drlg 2000'
2/2	Lansing 2911'
	Arbuckle 3252
	TD 3254'
	5" @ 3249'
2/9	"
2/16	"
2/23	"
3/2	Swb 4 bbls oil / 4 W PH
3/8	"
3/16	"
3/23	"
3/30	"
4/6	"
4/12	"
4/20	"
4/27	"
5/4	TD 3254'
	Arb. 3252'
	5" @ 3249'
	Pump 17 Oil Pot
	46° Gr.
	Comp

COMPLETED

Map No. _____ Sec. 18 Twp. 17 R. 9W

Well No. 1 Janzen

B & R Drlg. Company

LOG REPORT Contractor

SW SE

SECTION FLAT

_____ Ft. from N. Line

330 Ft. from S. Line

_____ Ft. from E. Line

330 Ft. from W. Line

Ellsworth County

RECORD

Location _____

Cased _____ in., _____ ft.

Rig up _____

Sand _____

Drilling and Remarks:

Gas _____

R U R

Oil _____

Total Depth _____

PRODUCTION

1st 24 hrs. Nat. _____

1st 24 hrs. after shot _____

Gas _____ Cu. Ft.

Dry Hole _____

Abandoned _____

Date

JAN 1 9 1949 19

S. J. LEWIS Scout

Kansas

Map No. 45 Sec. 18 Twp. 17 R. 9WWell No. 1 Janzen

B & R Drlg. _____ Company

CORRECTION _____ Contractor

SW NE SE


SECTION PLAT

990 Ft. from N. Line

_____ Ft. from S. Line

990 Ft. from E. Line

_____ Ft. from W. Line

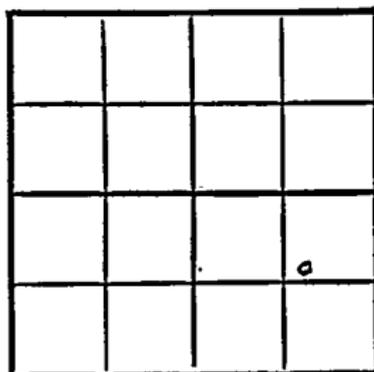

Ellsworth County

Location _____

Rig up _____

Drilling and Remarks:

Reported

SW SE

RECORD

Cased _____ in., _____ ft.

Sand _____

Gas _____

Oil _____

Total Depth _____

PRODUCTION

1st 24 hrs. Nat. _____

1st 24 hrs. after shot _____

Gas _____ Cu. Ft.

Dry Hole _____

Abandoned _____

Date

JAN 26 1949 19S. J. LEWIS Scout

Kansas

Map No. K 45 Sec. 18 Twp. 17 R. 9WWell No. 1 Janzen

B & R Drlg.

Company

COMPLETE

Contractor

SW NE SE

2/1/78
SECTION PLAT990 Ft. from N. Line Ft. from S. Line990 Ft. from E. Line Ft. from W. Line

			o

Ellsworth County

Location _____

Rig up _____

Drilling and Remarks:

*Cor 73252**5" @ 3245**Imp 17 oil 1/2**46 1/2*

RECORD

Cased _____ in., _____ ft.

Sand _____

Gas _____

Oil _____

Total Depth 3254

PRODUCTION

1st 24 hrs. Nat. _____

1st 24 hrs. after shot _____

Gas _____ Cu. Ft.

Dry Hole _____

Abandoned _____

Date

MAY 4 1949 19

S. J. LEWIS Scout