

KANSAS


Ellsworth

Form 51-5M-7-40-Palace

Section 18 Township 17 Range 9-W

Well No. #4 Men I

Company Gulf

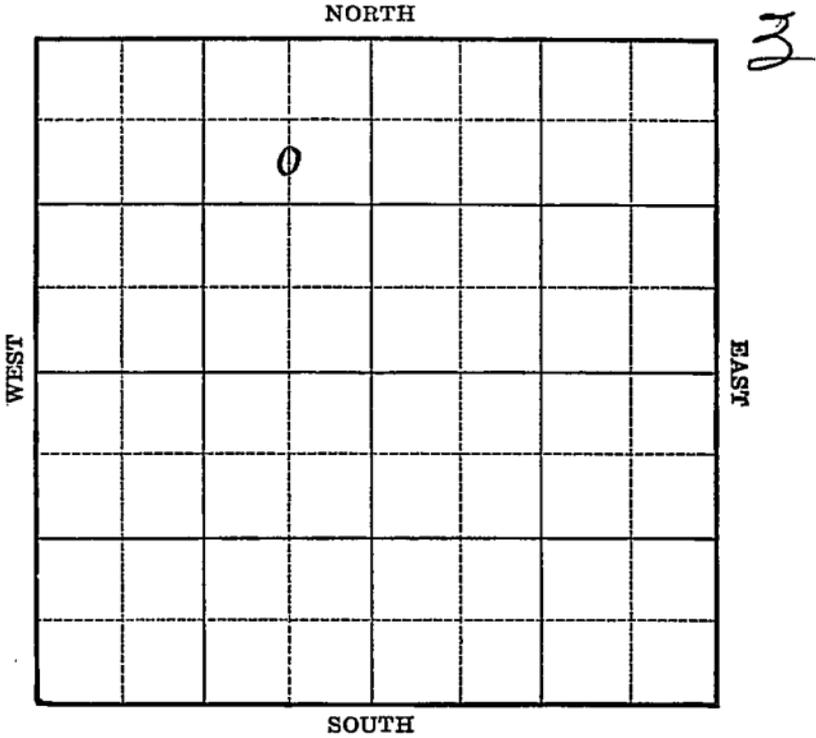

Sec. 18 Twp. 17 R. 9-W

Well No. #4 Mehl Farm _____

Gulf Company


(Schroeder)

990 Ft. from N. Line

_____ Ft. from S. Line

660 Ft. from E. Line

_____ Ft. from W. Line

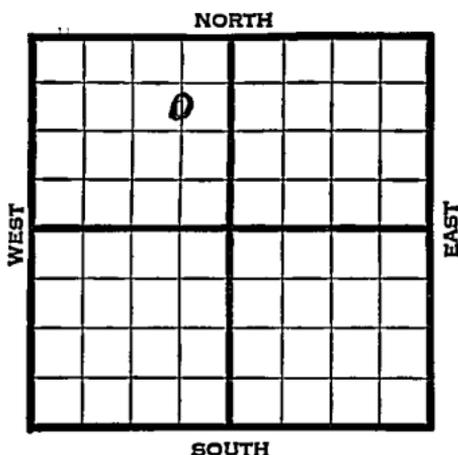

Elev. 1797

1941	REPORT
2/5	Derrick.
2/13	8" - 170' Drlg. 1542'
2/20	Drlg. 3240'
2/27	Arb. 3260½' 5" - 3261' T.D. 3272' 700' oil 8 hours.
3/6	1000 acid. Pump 155 bbls. potential. Drilled deeper to 3279½' T.D. 2500' oil 16 hours.
3/12	Arb. 3260½' 5" - 3261' T.D. 3279½' 3000 acid. Sonimeter potential 994 bbls. 40.1 Gravity
	COMPLETED

Map No. 45 Sec. 18 Twp. 17 R. 9WWell No. 4 MehlGulf Company~~FIRST REPORT~~ Contractor

SECTION PLAT

C S L NE NW

990 Ft. from N. Line Ft. from S. Line660 Ft. from E. Line Ft. from W. Line

SCHROEDER POOL

	o		

Location _____

Rig up _____

Drilling and Remarks:

Derrick

RECORD

Cased _____ in., _____ ft.

Sand _____

Gas _____

Oil _____

Total Depth _____

PRODUCTION

1st 24 hrs. Nat. _____

1st 24 hrs. after shot _____

Gas _____ Cu. Ft.

Dry Hole _____

Abandoned _____

Date

FEB 5 1941 19S. J. LEWIS Scout

Map No. 45 Sec. 18 Twp. 17 R. 9WWell No. 4 MehlGulf Company

Contractor

COMPLETED

C S L NE NW

990 Ft. from N. Line Ft. from S. Line660 Ft. from E. Line Ft. from W. Line

SCHROEDER POOL

SECTION PLAT

	o		

Location Rig up

Drilling and Remarks:

*Dr 32260 1/2**5" @ 3261.**3000 acid**sonic mated P & X**994**40' Br.***RECORD**Cased in., ft.Sand Gas Oil Total Depth 3278 1/2**PRODUCTION**1st 24 hrs. Nat. 1st 24 hrs. after shot Gas Cu. Ft.Dry Hole Abandoned

Date

MAR 12 1941 19S. J. LEWIS Scout