

KANSAS

Ellsworth


Section 18 Township 17 Range 9WWell No. 7 MehlCompany Gulf

Lorraine

NORTH

WEST

EAST

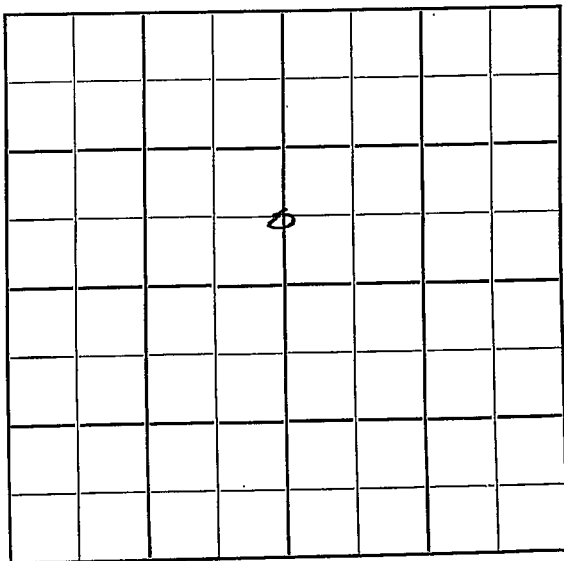

SOUTH

Ellsworth KANSAS

Sec. 18 Twp. 17 R. 9W

Well No. #7 Mehl Farm

Gulf

Company

Lorraine Pool

Ft. from N. Line

660'


Ft. from S. Line

2640'

Ft. from E. Line

Ft. from W. Line

C S $\frac{1}{4}$ N $\frac{1}{2}$ Sec.

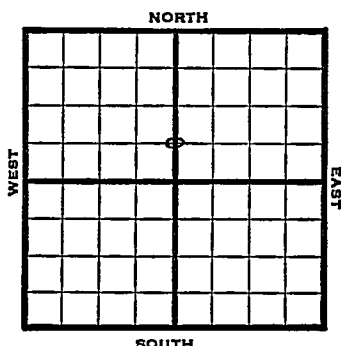

1949

Elev 1795'

R E P O R T

6/29 Location

7/6 10" @ 522'

Drlg. 743'

7/12 Drlg 2236'

7/20 Lansing 2923'

Arb. 3256-

Drlg 3725'

SWD

7/27 Granite 3792'-96'

TD 3796'

7"@ 3360'

8/3

8/10 TD 3796'

Arb. 3256'

Granite 3792'

7"@ 3360'

4000 acid

SWD

Aband.

ABANDONED

Kansas

Lorraine Pool


Map No. _____ Sec. 18 Twp. 17 R. 9W

Well No. 7 Meh1

Gulf

Company

Contractor

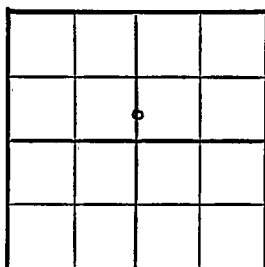C S $\frac{1}{2}$ N $\frac{1}{2}$ Sec.FIRST REPORT
SECTION PLAT

_____ Ft. from N. Line

660 _____ Ft. from S. Line

2640 _____ Ft. from E. Line

_____ Ft. from W. Line

Ellsworth County

Location _____ X

Rig up _____

Drilling and Remarks:

RECORD

Cased _____ in. _____ ft.

Sand _____

Gas _____

Oil _____

Total Depth _____

PRODUCTION

1st 24 hrs. Nat. _____

1st 24 hrs. after shot _____

Gas _____ Cu. Ft.

Dry Hole _____

Abandoned _____

Date

JUN 29 1949

19

S. J. LEWIS

Scout

Kansas

Map No. K43 Sec. 18 Twp. 17 R. 9WWell No. 7 Mehl

Gulf

Company

~~ABANDONED~~


Contractor

C $S\frac{1}{2}$ N $\frac{1}{2}$ Sec.E 11795
SECTION PLAT

Ft. from N. Line

660 Ft. from S. Line2640 Ft. from E. Line

Ft. from W. Line

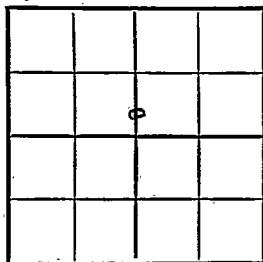

Ellsworth County

RECORD

Location

Cased _____ in., _____ ft.

Rig up

Sand _____

Drilling and Remarks:

Gas _____

Oil _____

Total Depth 3796

PRODUCTION

1st 24 hrs. Nat. _____

1st 24 hrs. after shot _____

Gas _____ Cu. Ft.

Dry Hole _____

Abandoned _____

Date

AUG 10 1949

19

S. J. LEWIS

Scout