


Section 18 Township 17 Range 9-W

Well No. #6 M. Mehl

Company Gulf

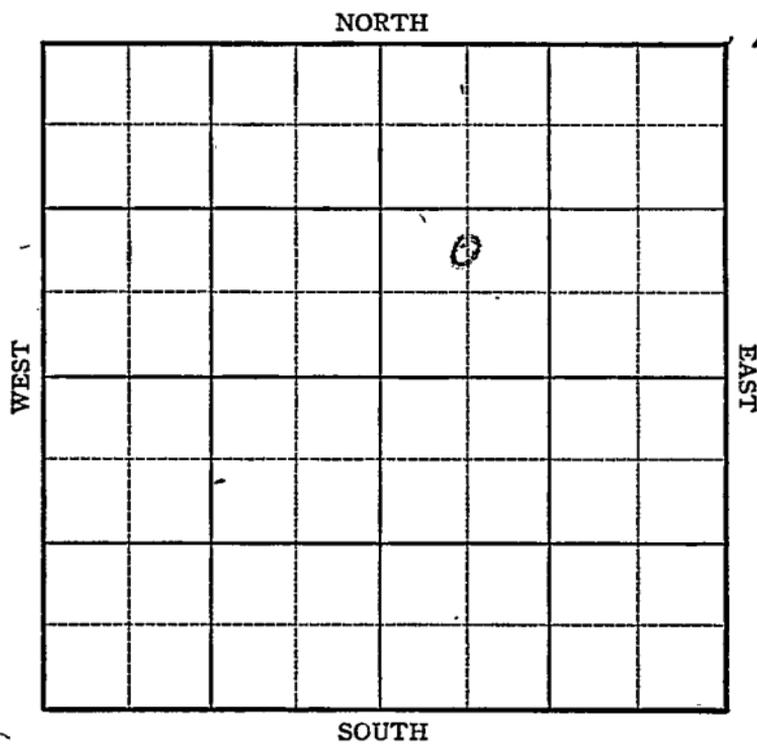

Sec. 18 Twp. 17 R. 9W

Well No. #6 M. Mehl Farm

Gulf Company

Stoltenberg


Ft. from N. Line

990 Ft. from S. Line

Ft. from E. Line

660 Ft. from W. Line

CNL SW NE

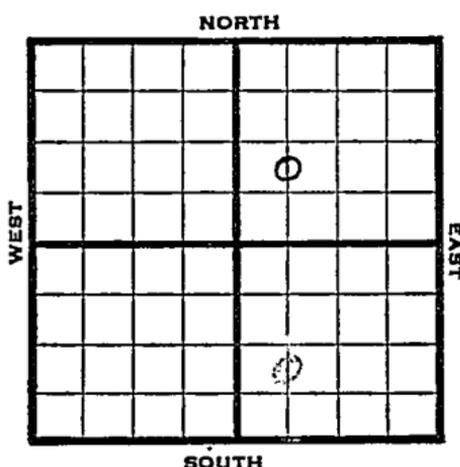

1946 Elev. 1792' REPORT

1/9 8" @ 429
Drig. 2630'

1/17 Arb. 3258-60' T.D. 5" - 3259'
RUST.

1/24 T.D. 3262' Swab 68 oil & 60l water 22
hours.

1/31 Pump 6 oil & 64 water 6 hours.

2/7 1000 acid. Pump 7 oil & 77 water in 4
hours.

2/14 " "

2/21 Pump 6 oil & 62 wtr in 4 hours.

2/28 " " "

3/6 Arb. 3258
5" @ 3259
1000 acid.
TD 3262'
Pump 72 oil plus 84% wtr. Pot.
Grav. 42.0

COMPLETED

