KANSAS


FORM 51 25M 3-49 PETROL Ellsworth

Section 18 Township 17 Range 9W

Well No. #1 Mehl

Company Pierce Drlg.

4

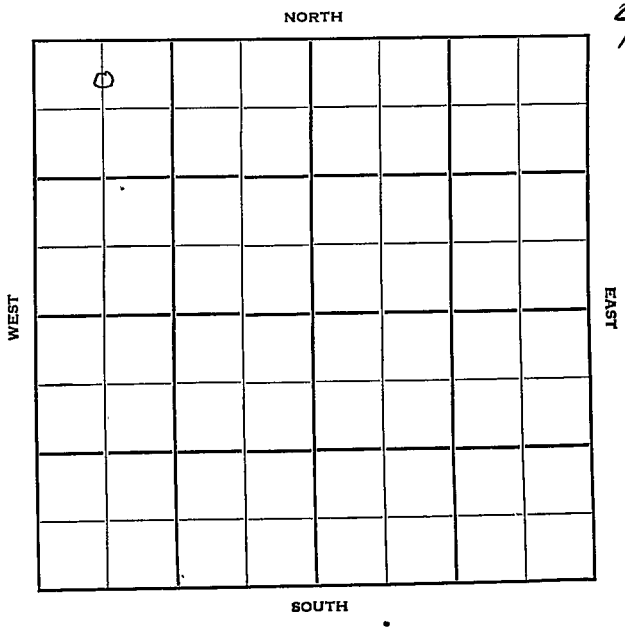

FORM 252-B
10M 11-50 PETROL

Ellsworth

KANSAS

Sec. 18 Twp. 17 R. 9 W

Well No. # 1 Mehl Farm

Pierce Drlg. Company

Contractor

Stoltenberg Pool

330 Ft. from N. Line


Ft. from S. Line

Ft. from E. Line

660 Ft. from W. Line

C N L NW NW

Gulf Farmout

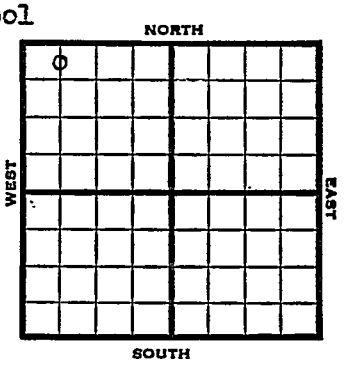

1951	Elev. 1780' REPORT
9/26	Location
1952	
2/6	TD 3231' 5" @ 3225' POP
2/13	Spud 10-4-51 Oil Well TD 3233 8" @ 175 DST 2495-2505 open 1hr. no rec. Heeb. 2772 Lans. 2898 Arb. 3224 DST 3225-31 open 1hr. rec. 30' hocm 5" @ 3225 TD 3233 1000 A Comp. 76 bopd

COMPLETED

FORM 275 FOR SALE BY KANSAS BLUE PRINT CO.


County Ellsworth State Kansas

Sec. 18 (Blk. Twp.) 17 (Sur. Rge.) 9W Map No.

Operator Pierce Drlg.

Well No. 1 Farm Mehl

Elev. Location C N L NW NW

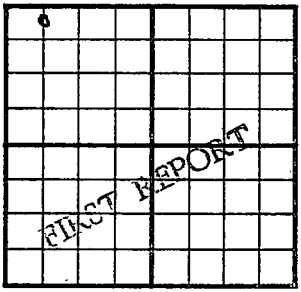

330 Ft. From N Line NW

660 Ft. From W Line Quarter

1st. Report SEP 26 1951

Completion

Remarks Gulf farmout

Spudding Date

Drlg. Data Stoltenberg Pool

Location

J. E. TYRA

FORM 275 FOR SALE BY KANSAS BLUE PRINT CO.


County Ellsworth State Kansas

Sec. 18 (Blk. Twp.) 17 (Sur. Rge.) 9W Map No.

Operator Pierce Drlg.

Well No. 1 Farm Mehl

Elev. 1780 Location C N L NW NW

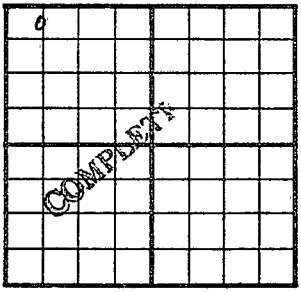

330 Ft. From N Line NW

660 Ft. From W Line Quarter

1st. Report

Completion FEB 13 1952

Remarks Stoltenberg Pool

Spudding Date 10-4-51

Drlg. Data Oil well TD 3233

8" @ 175 DST 2495-2505 open 1 hr.

no rec. Heeb. 2772 Lans. 2897

Arb. 3224 DST 3225-31 open 1 hr.

Rec. 30' hocm 5" @ 3225 TD 3233

1000 A Comp. 76 bopd

J. G. McGEHEE