

KANSAS

Form 51—5M—7-39—Palace


Ellsworth

Section 18 Township 17 Range 9-W

Well No. #2 Wilkins

Company Hollow Drilling

NORTH Wilkins Pool

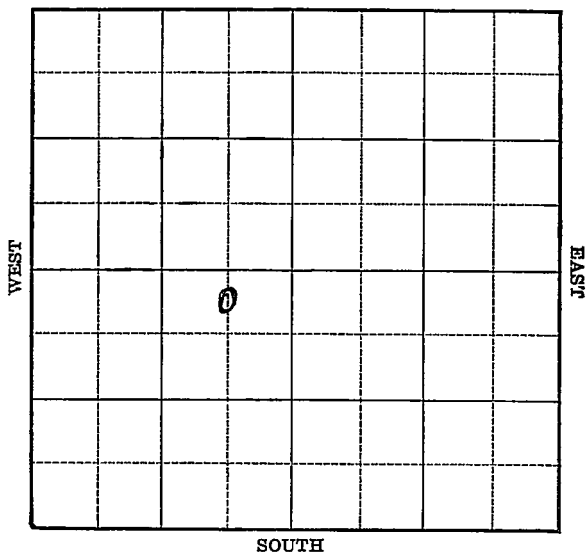

KANSAS

Ellsworth

Sec. 18 Twp. 17 R. 9-WWell No. #2 Wilkins FarmHollow Drilling

Company

(Wilkins)

330

Ft. from N. Line


Ft. from S. Line

660

Ft. from E. Line

Ft. from W. Line

Elev. 1793

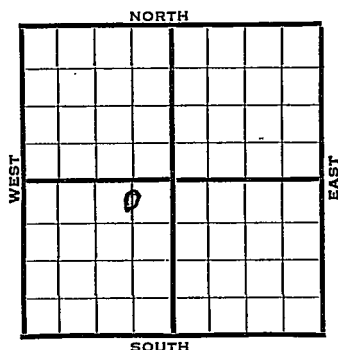

1940

REPORT

3/20

Derrick.

3/28

8" - 215' Drlg. 1865'

4/4

Lans. 2924' Drlg. 3068'

4/12

Simp. sand 3232' Arb. 3239'

5" - 3239' T.D. 3245' H.F.O. 2
hours.

4/17

Arb. 3239'

5" - 3239'

T.D. 3245'

Echometer potential 8516 bbls.

Maximum 3000 bbls.

COMPLETED

Map No. 45 Sec. 18 Twp. 17 R. 9WWell No. 2 WilkinsHollow Drilling

Company

Contractor

FIRST REPORT**C N L NE SW**330 Ft. from N. Line Ft. from S. Line660 Ft. from E. Line Ft. from W. Line**WILKINS POOL****SECTION PLAT**

	0		

Location Rig up

Drilling and Remarks:

Derrick**RECORD**Cased in., ft.Sand Gas Oil Total Depth **PRODUCTION**1st 24 hrs. Nat. 1st 24 hrs. after shot Gas Cu. Ft.Dry Hole Abandoned

Date

Mar. 20 1940

19

S. J. LEWIS

Scout

Map No. 45 Sec. 18 Twp. 17 R. 9WWell No. 2 WilkinsHollow Drilling Company

Contractor

COMPLETED**SECTION PLAT**

	6		

C N L NE SW330 Ft. from N. Line Ft. from S. Line660 Ft. from E. Line Ft. from W. Line**WILKINS POOL**Location Rig up

Drilling and Remarks:

*Cu 43238**5" C 3238**Echometer Rx**8516**Maximum 3000***RECORD**Cased in., ft.Sand Gas Oil Total Depth 3245**PRODUCTION**1st 24 hrs. Nat. 1st 24 hrs. after shot Gas Cu. Ft.Dry Hole Abandoned

Date

APR 17 1940 19 S. J. LEWIS Scout