

KANSAS

Form 51-5M-7-40-Palace


Ellsworth

Section 18 Township 17 Range 9-W

Well No. 3 Wilkins

Company Hollow Drilling

NORTH Schroeder Pool

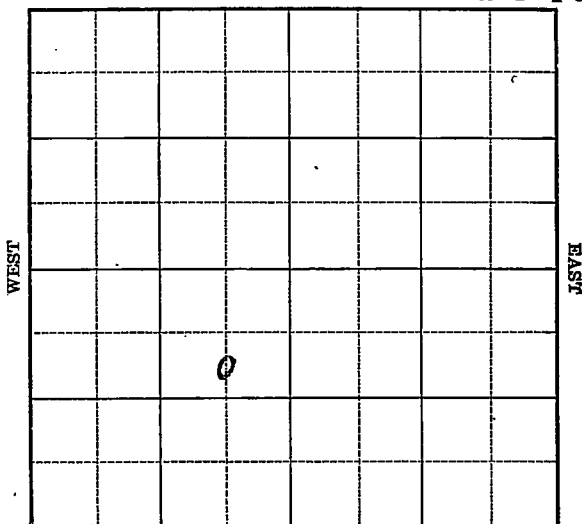

SOUTH

KANSAS

Ellsworth

Sec. 18 Twp. 17 R. 9-WWell No. #3 Wilkins FarmHollow Drilling

Company

(Schroeder)


990 Ft. from N. Line

Ft. from S. Line

660 Ft. from E. Line

Ft. from W. Line

Elev. 1794

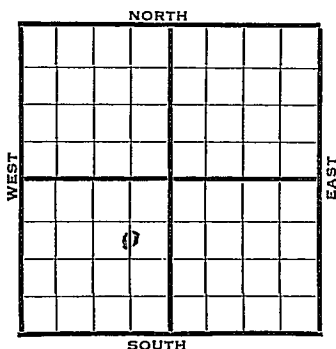

1941

REPORT

1/15

Arb. 3248-50' T.D.

5" - 3249' RUST.

1/22

Arb. 3248'

5" - 3249'

T.D. 3252'

Echometer potential 3656 bbls.

Maximum 3000 bbls.

40.1 Gravity

COMPLETED

Map No. 45 Sec. 18 Twp. 17 R. 9WWell No. 3 WilkinsHollow Drilling Company

Contractor

FIRST REPORT

C S L NE SW

990 Ft. from N. Line Ft. from S. Line660 Ft. from E. Line Ft. from W. Line**SECTION PLAT**

SCHROEDER POOLLocation Rig up

Drilling and Remarks:

Arb. 3248-50 TD

5" - 3249 RUST

RECORDCased in., ft.Sand Gas Oil Total Depth **PRODUCTION**1st 24 hrs. Nat. 1st 24 hrs. after shot Gas Cu. Ft.Dry Hole Abandoned

Date

JAN 15 1941

S. J. LEWIS

Scout

Form 26—200 Bks.—1-40—Palace Ellsworth **KANSAS**

Map No. 45 Sec. 18 Twp. 17 R. 9W

Well No. 3 Wilkins

Hollow Drilling Company

Contractor

COMPLETED

C S L NE SW

990 Ft. from N. Line

 Ft. from S. Line

660 Ft. from E. Line

 Ft. from W. Line

SECTION PLAT

SCHROEDER POOL

Location

Rig up

Drilling and Remarks:

Cr 83248

5" @ 3249

Echo P. 83656

Max 8000

40' @ 82.

RECORD

Cased in., ft.

Sand

Gas

Oil

Total Depth 3252

PRODUCTION

1st 24 hrs. Nat.

1st 24 hrs. after shot

Gas Cu. Ft.

Dry Hole

Abandoned

Date

JAN 22 1941

S. J. LEWIS

Scout