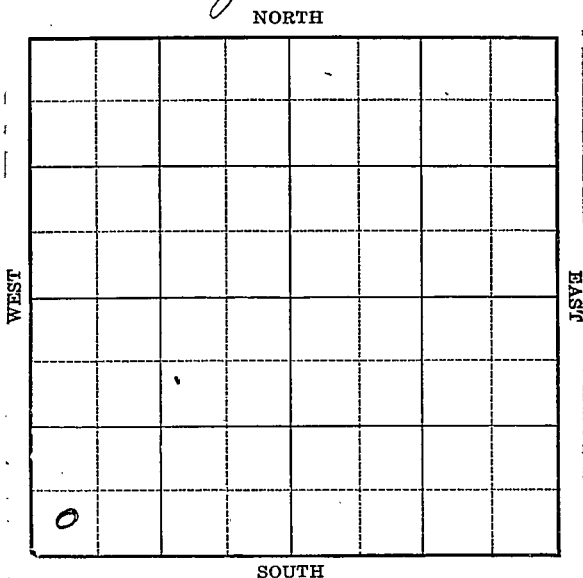


Ellsworth

Form 51-5M-11-31-Palace

Map No. **KANSAS** Sec. 18 Twp. 17 R. 9<sup>W</sup>Well No. 1 Wilkins "B" lease Farm  
Slick - Pryor & Lockhart Company

Location.....

Drilling Remarks

Rig Up.....

Drilling Remarks

## RECORD

Cased.....in. ....ft.

Sand.....

Gas.....

Oil.....

Total Depth.....

## PRODUCTION

1st 24 hrs. Nat.....

1st 24 hrs. after shot.....


Gas.....cu. ft.

Dry Hole.....

Abandoned.....

Well No. 1 Wilkins "B" lease Farm  
Slick-Pryor & Lockhart Company  
NORTH

330 Ft. from W. Line

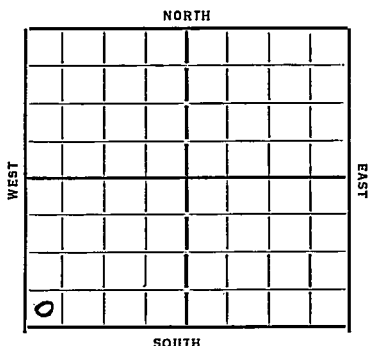

REPORT *E1. 1803*

5/30 Cellar  
6/7 Bldg Rig  
6/14 Rign up  
6/21 Spud  
6/28 Bldg 1465 20" 139 15 1/2 366  
7/5 " 2085  
7/12 Bldg 3075 8" 2555  
7/19 Cong 3242 Shl 3263  
5" 3260 TD 3285  
hook 217 Bbls 21 hrs.  
7/26 1000 acid No test  
8/1 Silicums 3263 TD 3285  
1000 acid 538 Bbls.

**COMPLETED**

Map No. K7NS Sec. 18 Twp. 17 R. 9W

Well No. 1 Wilkins "B" Lease

Click-Payor & Lockhead Company  
Contractor

# SECTION PLAT

|  |  |  |  |
|--|--|--|--|
|  |  |  |  |
|  |  |  |  |
|  |  |  |  |
|  |  |  |  |

FIRST REPORTS

         Ft. from N. Line

230 Ft. from S. Line

         Ft. from E. Line

320 Ft. from W. Line

Location                                 

Rig up                                 

Drilling and Remarks:

Cellar

## RECORD

Cased          in.,          ft.

Sand                                 

Gas                                 

Oil                                 

Total Depth                         

## PRODUCTION

1st 24 hrs. Nat.                         

1st 24 hrs. after shot                         

Gas                                  Cu. Ft.

Dry Hole                                 

Abandoned                                 

Date

5/30

ORVAL MANNSCHRECK

1934

Scout

*Edworth*  
 Map No. 45 Sec. 18 Twp. 17 R. 9W

Well No. 1- Wilkins 'B'

*Click P + L* Company  
 Contractor

**COMPLETED**

# SECTION PLAT

|  |  |  |  |
|--|--|--|--|
|  |  |  |  |
|  |  |  |  |
|  |  |  |  |
|  |  |  |  |

       Ft. from N. Line

330 Ft. from S. Line

       Ft. from E. Line

330 Ft. from W. Line

Location                                 

Rig up                                 

Drilling and Remarks:

*1000 gallon*

*538 bbls*

## RECORD

Cased        in.,        ft.

Sand *siliceous* 3263

Gas                                 

Oil                                 

Total Depth 3285

## PRODUCTION

1st 24 hrs. Nat.                                 

1st 24 hrs. after shot                                 

Gas                                  Cu. Ft.

Dry Hole                                 

Abandoned                                 

Date

*8-1-34* 19

ORVAL MANNSCHRECK Scout