

KANSAS

Form 51-5M-7-40-Palace

Ellsworth


Section 18 Township 17 Range 9-W

Well No. 3 Wilkins "BB"

C.E. Ash et al

Company ~~Comet~~ Drilling

NORTH Schroeder Pool

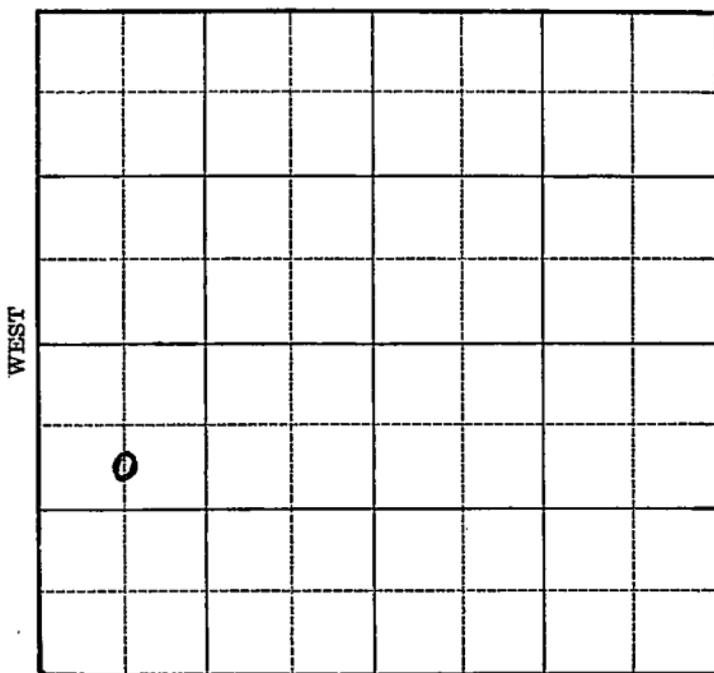

SOUTH

Sec. 18 Twp. 17 R. 9-W

Well No. #3 Wilkins "BB" Farm

C.E. Ash et al
Concrete Drilling

Company

(Schroeder)


990 Ft. from N. Line

 Ft. from S. Line

 Ft. from E. Line

660 Ft. from W. Line

Elev. 1796

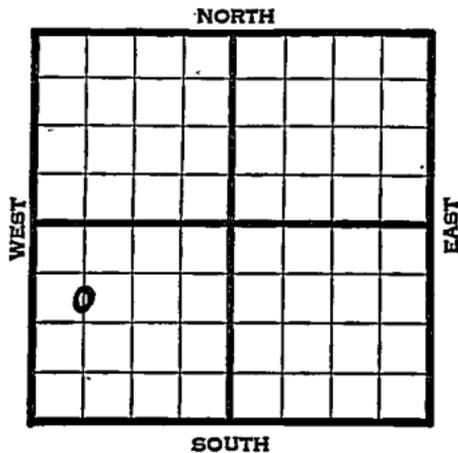

1941

REPORT

2/26

Cellar.

3/6

"

3/13

"

3/20

"

3/27

8" - 185'

Drlg. 435'

4/2

Drlg. 2785'

4/10

Arb. 3253-57' T.D. 5" - 3255'

RUST.

4/18

"

4/24

"

5/1

T.D. 3267' 1300' oil.

500 acid.

5/8

1000 acid. Testing.

5/15

" " "

5/22

" " "

5/28

" " "

6/5

" " "

6/12

" " "

6/19

" " "

OVER

1941

6/25

Arb. 3253'

5" - 3255'

T.D. 3267'

1500 acid.

Potential 60 bbls., pump.

COMPLETED

Map No. 2/5 Sec. 18 Twp. 17 R. 9W

Well No. 3 Wilkins

Comet Drilling Company

Contractor

FIRST REPORT

C S L NW SW

990 Ft. from N. Line

_____ Ft. from S. Line

_____ Ft. from E. Line

660 Ft. from W. Line

SECTION PLAT

SCHROEDER POOL

Location _____

Rig up _____

Drilling and Remarks:
Cellar

RECORD

Cased _____ in., _____ ft.

Sand _____

Gas _____

Oil _____

Total Depth _____

PRODUCTION

1st 24 hrs. Nat. _____

1st 24 hrs. after shot _____

Gas _____ Cu. Ft.

Dry Hole _____

Abandoned _____

Date

FEB 26 1921 19

S. J. LEWIS Scout

Misc. Small Maps
Cards
Tracing
France Map
Scarborough Map
Moody Map
Geological Dept.
Moody Flat Bock

Map No. 45 Sec. 18 Twp. 17 R. 9W

Well No. 3 Wilkins "BB"

C. E. Ash etal Company

CORRECTION Contractor

SECTION PLAT

C S L NW SW
990 Ft. from N. Line
 _____ Ft. from S. Line
 _____ Ft. from E. Line
660 Ft. from W. Line

SCHROEDER POOL

Location _____

Rig up _____

Drilling and Remarks:

Reported as

Comet Drilling

#3 Wilkins

RECORD

Cased _____ in., _____ ft.

Sand _____

Gas _____

Oil _____

Total Depth _____

PRODUCTION

1st 24 hrs.-Nat. _____

1st 24 hrs. after shot _____

Gas _____ Cu. Ft.

Dry Hole _____

Abandoned _____

Date

MAR 12 1941 19

S. J. LEWIS Scout

Misc Small Maps	<i>Part</i>
Cards	<i>Part</i>
Tracing	<i>Part</i>

Map No. 45 Sec. 18 Twp. 17 R. 9WWell No. 3 Wilkins "BB"C. E. Ash etal Company

Contractor

COMPLETED

C S L NW SW

990 Ft. from N. Line

_____ Ft. from S. Line

_____ Ft. from E. Line

660 Ft. from W. Line

SCHROEDER POOL

SECTION PLAT

Location _____

Rig up _____

Drilling and Remarks:

*See #3253
5" @ 3253.
1500 acid
Pump 60 P.D.*

RECORD

Cased _____ in., _____ ft.

Sand _____

Gas _____

Oil _____

Total Depth 3267

PRODUCTION

1st 24 hrs. Nat. _____

1st 24 hrs. after shot _____

Gas _____ Cu. Ft.

Dry Hole _____

Abandoned _____

Date

JUN 25 1941 19S. J. LEWIS Scout

Misc. Small Maps	<i>PAW</i>
Cards	<i>PAW</i>
Tracing	<i>PAW</i>
France Map	<i>PAW</i>
Scarborough Map	<i>PAW</i>
Moody Map	<i>PAW</i>
Geological Dept.	
Moody Plat Book	