


Section 18 Township 17 Range 9-W

Well No. #4 Wilkins "BB"

Company C. E. Ash et al

NORTH **Schroeder Pool**

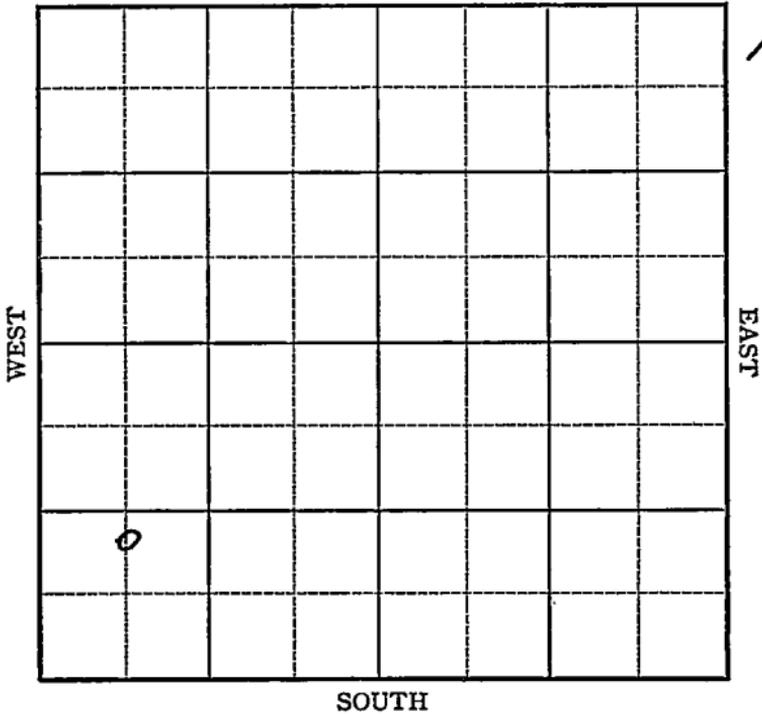

13

SOUTH

Sec. 18 Twp. 17 R. 9-W

Well No. #4 Wilkins "BB" Farm

C. E. Ash et al Company

(Schroeder)


_____ Ft. from N. Line

990 Ft. from S. Line

_____ Ft. from E. Line

660 Ft. from W. Line

Elev. 1799

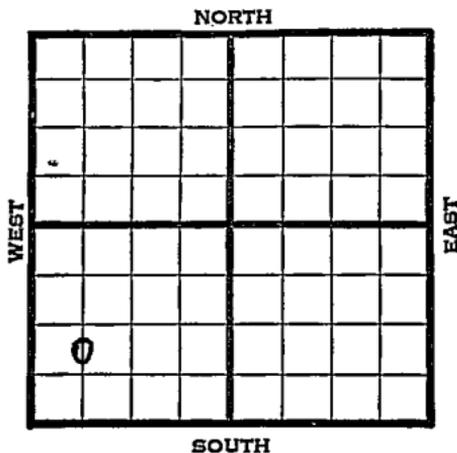

| 1941 | REPORT |
|------|-----------------------------|
| 4/2 | Derrick. |
| 4/10 | " |
| 4/18 | 8" - 185' Drlg. 600' |
| 4/24 | Drlg. 2800' |
| 5/10 | Arb. 3253-58' T.D. |
| | 5" - 3254' RUST. |
| 5/8 | " " " |
| 5/15 | T.D. 3270' 17 qts. 3256-70' |
| | C.O. |
| 5/22 | 200' oil. 2500 acid. |
| 5/28 | " " " " |
| 6/5 | " " " " |
| 6/12 | " " " " |
| 6/19 | " " " " |
| | OVER |

1941
6/25

Arb. 3253'
5" - 3254'
T.D. 3270'
Shot 17 qts. 3256-70'
2500 acid.
Potential 15 bbls., pump.

COMPLETED

Map No. 45 Sec. 18 Twp. 17 R. 9W

Well No. 4 Wilkins "BB"

C. E. Ash etal Company

Contractor

FIRST REPORT

C N L SW SW

SECTION PLAT

| | | | |
|--|--|--|--|
| | | | |
| | | | |
| | | | |
| | | | |

 Ft. from N. Line

990 Ft. from S. Line

 Ft. from E. Line

660 Ft. from W. Line

SCHROEDER POOL

Location

Rig up

Drilling and Remarks:

Derrick

RECORD

Cased in., ft.

Sand

Gas

Oil

Total Depth

PRODUCTION

1st 24 hrs. Nat.

1st 24 hrs. after shot

Gas Cu. Ft.

Dry Hole

Abandoned

Date

APR 2 1941 19

S. J. LEWIS Scout

Don - Our map shows a #1 Comp. Well
operated by Western Pet. in NW SW SW.
Please have scout check.

Pittman

| | |
|------------------|-------------|
| Misc. Small Maps | <i>Paul</i> |
| Cards | <i>Paul</i> |
| Tracing | <i>Jim</i> |
| France Map | <i>Paul</i> |
| Scarborough Map | <i>Paul</i> |
| Moody Map | <i>Jim</i> |
| Geological Dept. | |
| Moody Flat Back | |

Map No. _____ Sec. 18 Twp. 17 R. 9W

Well No. 4 Wilkins "BB"

C. E. Ash etal _____ Company

CORRECTION _____ Contractor

C N L SW SW

_____ Ft. from N. Line


990 Ft. from S. Line

_____ Ft. from E. Line

600 Ft. from W. Line

SCHROEDER POOL

SECTION PLAT

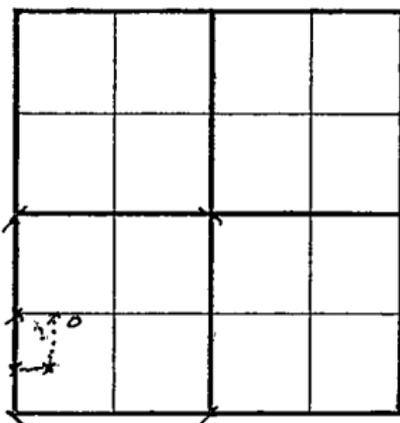

Location _____

Rig up _____

Drilling and Remarks:

They have all SW $\frac{1}{4}$ with exception of NW 10 A. of the SW $\frac{2}{4}$ SW

RECORD

Cased _____ in., _____ ft.

Sand _____

Gas _____

Oil _____

Total Depth _____

PRODUCTION

1st 24 hrs. Nat. _____

1st 24 hrs. after shot _____

Gas _____ Cu. Ft.

Dry Hole _____

Abandoned _____

Date

APR 18 1941

19

S. J. LEWIS

Scout

Don - The Ft. Meas. of this Loc. ~~is~~
would put it inside of the 10 Ac. omitted
from this Lease.

Pittman

Map No. _____ Sec. 18 Twp. 17 R. 9W

Well No. 4 Wilkins "BB"

C. E. Ash et al _____ Company

CORRECTION _____ Contractor

C N L SW SW

_____ Ft. from N. Line

990 Ft. from S. Line

_____ Ft. from E. Line

660 Ft. from W. Line

Schroeder POOL

SECTION PLAT

| | | | |
|--------|--|--|--|
| | | | |
| | | | |
| | | | |
| 0 v | | | |

Location _____

Rig up _____

Drilling and Remarks:

RECORD

Cased _____ in., _____ ft.

Sand _____

Gas _____

Oil _____

Total Depth _____

PRODUCTION

1st 24 hrs.-Nat. _____

1st 24 hrs. after shot _____

Gas _____ Cu. Ft.

Dry Hole _____

Abandoned _____

Date

APR 25 1941 19

S. J. LEWIS Scout

Misc. Small Maps
Cards
Tracing
France Map
Scarborough Map
Moody Map
Geological Dept.
Moody Flat Book

Handwritten signatures and initials, including "JAH" and "JAH" written over the list items.

Sandy:

We are right back where we started from on this well.

The Engineering Dept. wouldn't take it like it was the first time so I don't think they will now.

If Western Pet. retained the NW 10 acres, these feet measurements put the well right on the line. Please check.

Don Schumaker

*This is just where the well is located
and I can't put any place & be*

Sandy