

# KANSAS


Ellsworth

FORM 51 5M BR1X

Section 18 Township 17 Range 10W

Well No. #1, Murray

Company Ingling & Alpine

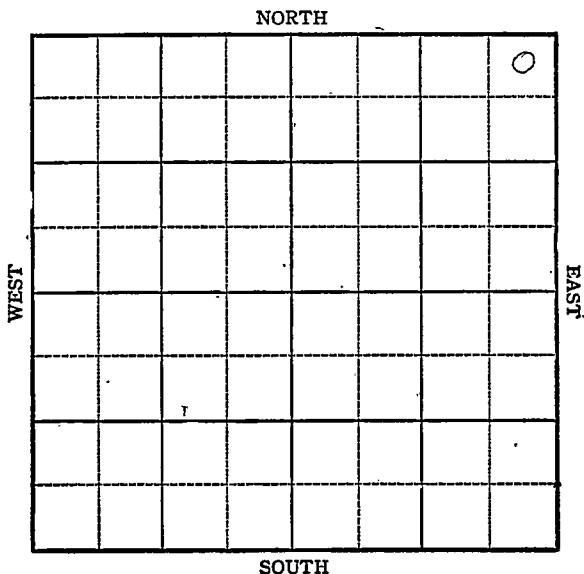

Sec. 18 Twp. 17 R. 10W

Well No. #1 Murray Farm

Ingling & Alpine Company


Bloomer

330 Ft. from N. Line

\_\_\_\_\_ Ft. from S. Line

330 Ft. from E. Line

\_\_\_\_\_ Ft. from W. Line

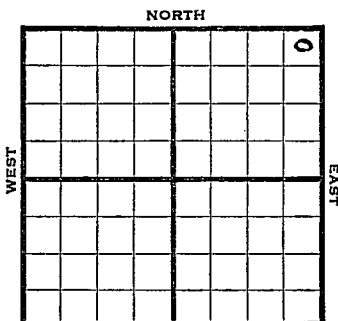

NE/C Elev. 1256

REPORT

1944

5/24	8" @ 221'					
	WOC					
5/31	Drlg. 2431					
6/7	Topeka 2625					
	Lans 3003					
	Cong. 3291					
	Arb. 3309-11 TD					
	5" @ 3310 RUST					
6/15	" " "					
6/21	TD 3332					
	5500 acid					
	2 1/2 oil per hr.					
6/28	" " " "					
7/12	TD 3332	5500 acid		2 1/2 oil		
	per hr					
7/19	" "	" "		" "		
7/26	" "	" "		" "		
8/9	Arb. 3309					
	5" @ 3310					
	5500 acid.					
P	Pump. 35 Pot.					
	TD 3332					
	Grav. 42.0					
	COMPLETED					



**KANSAS**

Pool Name Bloomer

Map No. 5 Sec. 18 Twp. 17 R. 10W

Well No. 1 Murray

Ingling & Alpine Company

**COMPLETED** Contractor

NE/C

**SECTION PLAT**

330 Ft. from N. Line

\_\_\_\_\_ Ft. from S. Line

330 Ft. from E. Line

\_\_\_\_\_ Ft. from W. Line

			o

Ellsworth County

Location \_\_\_\_\_

Rig up \_\_\_\_\_

Drilling and Remarks:

*Co #3309  
5" @ 3310  
5500 cu ft  
Pump 35 Bx*

*42 1/2 ft*

**RECORD**

Cased \_\_\_\_\_ in., \_\_\_\_\_ ft.

Sand \_\_\_\_\_

Gas \_\_\_\_\_

Oil \_\_\_\_\_

Total Depth 332

**PRODUCTION**

1st 24 hrs. Nat. \_\_\_\_\_

1st 24 hrs. after shot \_\_\_\_\_

Gas \_\_\_\_\_ Cu. Ft.

Dry Hole \_\_\_\_\_

Abandoned \_\_\_\_\_

Date

AUG 9 1944 19 \_\_\_\_\_

S. J. LEWIS Scout