


Section 18 Township 17 Range 10W

Well No. #1 Murry

Company El Dorado

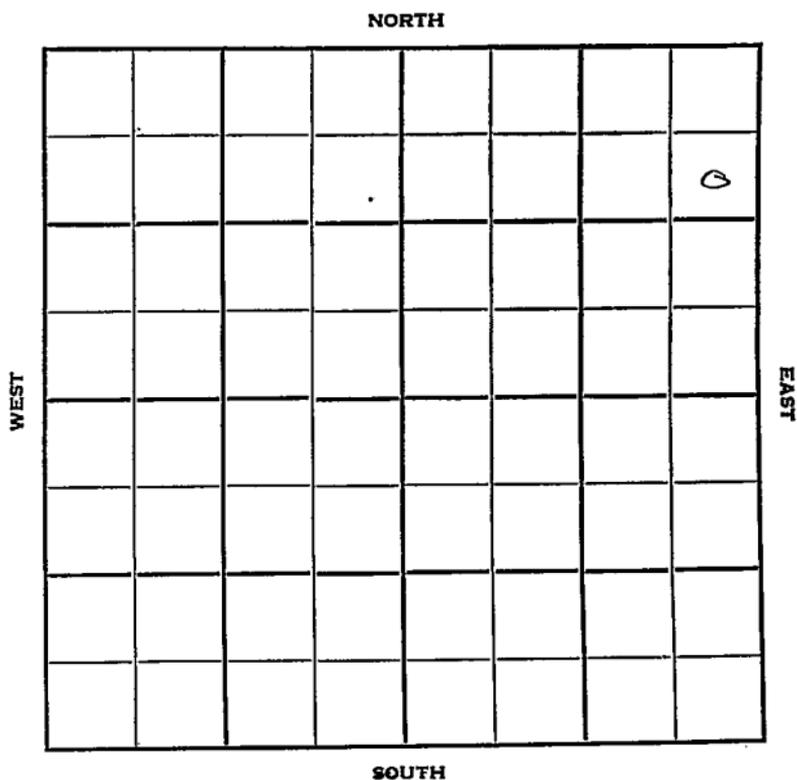

Sec. 18 Twp. 17 R. 10W

Well No. #1 Murry Farm

El Dorado Company

Contractor


990 Ft. from N. Line

_____ Ft. from S. Line

330 Ft. from E. Line

_____ Ft. from W. Line

SE NE NE

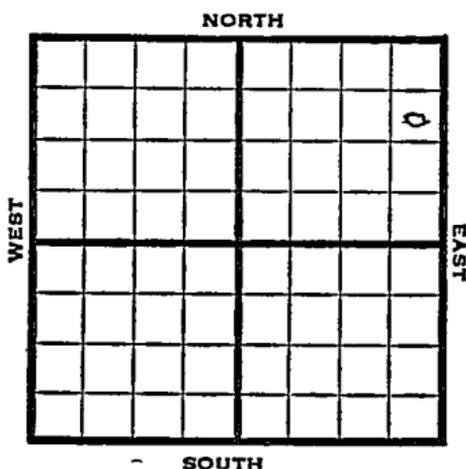

1952 Elev. 1855' REPORT

2/6 Location

2/13 Heeb 2871' Tor 2889'
Br Li 2980' Lans. 2993'
Drlg. 3145'

2/20 Cong. 3288 Arb. 3301
RTD 3304 5" @ 3303' WOCT

2/27 Spud 2-5-52
D&A TD 3345
8" @ 285'
Heeb. 2871 Tor. 2889
Br Li 2980 Lans. 2993
Cong. 3288 Arb. 3301
TD 3304 5" @ 3303 DD 3345
D&A

ABANDONED

