


Section 18 Township 17 Range 10-W

Well No. 1 - John Myers

Company Transwestern

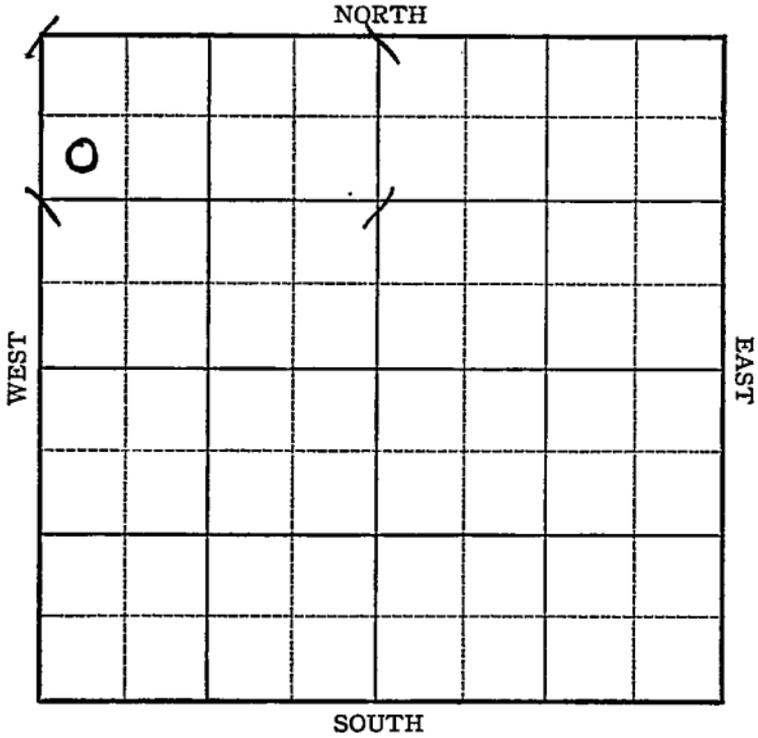

Sec. 18 Twp. 17 R. 10-W

Well No. #1 John Myers Farm

Transwestern Company


990 Ft. from N. Line

\_\_\_\_\_ Ft. from S. Line

\_\_\_\_\_ Ft. from E. Line

330 Ft. from W. Line

Elev. 1878

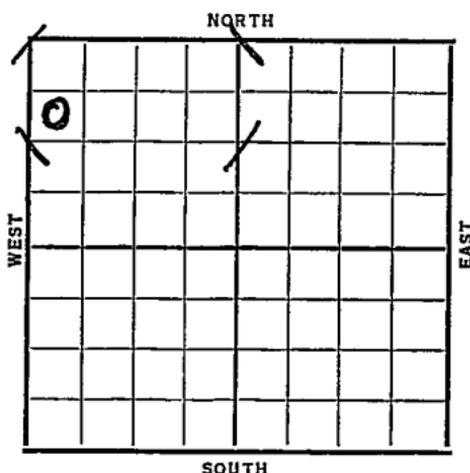

Date	REPORT
1937	
8/18	Bldg. rig.
8/28	R. U.
9/3	Drlg. 375'.
9/10	20" @ 230'. 15" @ 398'.
	13" @ 630'. Anh. 625'.
	Drlg. 1500'.
9/17	10" @ 1935'. T.D. 1990' U.R.
9/24	10" @ 2216'. Drlg. 2260'.
10/2	S.G. 2750-55'. K.C. 2985'.
	500' oil @ 3085-90'.
	8" @ 3090'. C.O.
10/9	8" @ 3084'. Drlg. 3145'.
10/15	Sil. 3288'. T.D. 3296'.
	Rng. 7". No shows reported.
10/22	Did not have Siliceous.
	Cong. 3273-3303'.
	Quartzite 3303-06' T.D.
	No shows. P.B. 3205'. WOC.
10/29	P.B. 3082'.

OVER

1937

11/5 38 lane wells shots 3074-81'.  
Swab 1 bbl. oil & 3 bbls. water.  
S.D.

11/12 SD @ 3081'.

11/19 " "

11/26 " "

12/3 " "

12/10 " "

12/17 " "

12/24 " "

12/30 " "

1938

1/5 Cong. 3273-3303'.

Quartzite 3303-06'.  
(No Arbuckle Lime)

T.D. 3306'.

No shows.

P.B. 3082'.

38 shots 3074-81'.

**ABANDONED**

*Edsworth* KANSAS

Map No. \_\_\_\_\_ Sec. 18 Twp. 17 R. 10<sup>W</sup>

Well No.: 1 - John Myers

Transwestern Company

Contractor

FIRST REPORT

SECTION PLAT

990 Ft. from N. Line

\_\_\_\_\_ Ft. from S. Line

\_\_\_\_\_ Ft. from E. Line

330 Ft. from W. Line


Location \_\_\_\_\_

Rig up \_\_\_\_\_

Drilling and Remarks:

*Bldg Rig*

RECORD

Cased \_\_\_\_\_ in., \_\_\_\_\_ ft.

Sand \_\_\_\_\_

Gas \_\_\_\_\_

Oil \_\_\_\_\_

Total Depth \_\_\_\_\_

PRODUCTION

1st 24 hrs. Nat. \_\_\_\_\_

1st 24 hrs. after shot \_\_\_\_\_

Gas \_\_\_\_\_ Cu. Ft.

Dry Hole \_\_\_\_\_

Abandoned \_\_\_\_\_

Date

AUG 18 1937 19

H. D. Hatfield

Scout

*John*

TA 4. 1824 4

Returned	<i>[Signature]</i>
Cards	<i>[Signature]</i>
Tracing	<i>[Signature]</i>
France Map	<i>[Signature]</i>
Scarborough Map	<i>[Signature]</i>
Moody Map	<i>[Signature]</i>
Scarborough Plat Book	<i>[Signature]</i>
Moody Plat Book	<i>[Signature]</i>

Map No. 55 Sec. 18 Twp. 17 R. 10WWell No. 1 John R. MyersTranswestern Company

Contractor

## ABANDONED

SW NW NW

990 Ft. from N. Line

\_\_\_\_\_ Ft. from S. Line

\_\_\_\_\_ Ft. from E. Line

330 Ft. from W. Line

## SECTION PLAT

6			

Location \_\_\_\_\_

Rig up \_\_\_\_\_

Drilling and Remarks:

Cong 3273-3303  
 quartzite 3303-06  
 (No Arbuckle Lime)  
 No shows  
 P.B. 3080  
 38 shots 3074-81  
 DVA

## RECORD

Cased \_\_\_\_\_ in., \_\_\_\_\_ ft.

Sand \_\_\_\_\_

Gas \_\_\_\_\_

Oil \_\_\_\_\_

Total Depth 3306

## PRODUCTION

1st 24 hrs. Nat. \_\_\_\_\_

1st 24 hrs. after shot \_\_\_\_\_

Gas \_\_\_\_\_ Cu. Ft.

Dry Hole \_\_\_\_\_

Abandoned \_\_\_\_\_

Date

JAN 5 - 1938 19

H. D. Hatfield Scout

AT

[Faint, mostly illegible text, possibly a list or notes, with some handwritten marks.]

[Handwritten signature or initials, possibly "KADY"]

Delivered	_____
By	<i>Paul</i>
Date	<i>Jan 1950</i>
Time	<i>1:30</i>
Initials	<i>KADY</i>
Signature	<i>[Signature]</i>
Seal	_____
Postmark	_____