


DX 78-1 Ellsworth

KANSAS

Section 18 Township 17S Range 10W

Well No. #2 Myers

Company El Dorado Refining

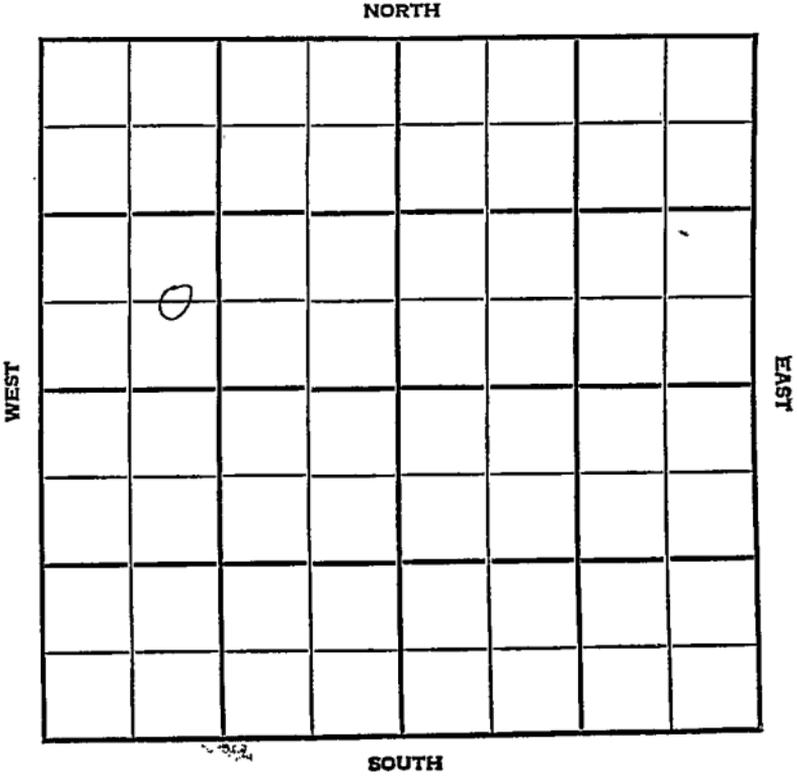

Ellsworth

KANSAS

SEC. 18	TWP. 17S	R. 10W
------------	-------------	-----------

WELL NO.

#2 Myers

FARM

COMPANY

Eldorado Refining

CONTRACTOR

Walters


Kraft-Prusa

_____ FT. FROM N. LINE

_____ FT. FROM S. LINE

_____ FT. FROM E. LINE

_____ FT. FROM W. LINE

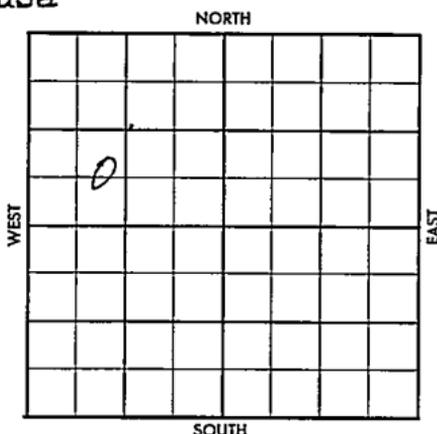~~#####~~

E/2 SW NW

1956	ELEVATION 1859'	REPORT
------	--------------------	--------

7-25

Location

8-22

Comm. 7-25-56

8 5/8" @ 3381w/190

DST 3307-17 op 1 hr., rec. 30' socm,
BHP 975/20".

5 1/2" @ 3313 1/2

CO 3317

4 1/2 GW ≠ GSO

S/ 140 BF 6 1/2 hrs. (4.21 B0) 1000' O.B.

CO 3314 8/3311-13 SSW no oil,

S/ 1.67 B0 ≠ 32.33 BW, 24 hrs.

D & A

Anh. 621'; H. 2870'; Tr. 2886';

Dg. 2899'; BL. 2974'; L. 2996';

C. 3272'; A. 3307';

TD 3317'

ABANDONED

County Ellsworth Elev. 1857
 Sec. 18 Twp. 17S Rge. 10W
 Company Eldorado Refining
 Farm Name Myers No. 2

TOPS	DEPTH	LOG	DATUM	Loc. in Sec.
Anh.	621			E/2 SW NW
TP.				
H.	2870			
Tr.	2886			
Dg.	2899			
Bl.	2974			
L.	2996			
K.C.				Geol.
B.K.C.				
Ce.				Center
C.	3272			Walters
M.				Pool <u>Bloomer</u>
M.				Kraft-Prusa
K.				
Mz.				
Ma.				
V.				
S.				
S.				ABANDONED
A.	3307			
R.				
PE.				
G.				
				AUG 22 1956
TD.	3317			

Date Comm. LOC. AUG 1 '55 7-25-56
 8 5/8 338/190 D 2775
 AUG 8 '55 DST 3307-17 cor 1 hr
 dec 30' 50 CM BHP 975/20
 5 1/2 3313 1/2 AUG 15 '55 co 3317 R.T.D.
 4 1/2 GW + 650 1/4 \$ 140
 BF 6 1/2 hrs (4.21 BO) 1000'
 O.B. 50d co 3314 8/3311-13
 SSW no oil 1/4 AUG 22 '56 \$ 1,67 BO
 + 32.33 BW 24 hrs D & A

Co.

Co.

No.

Sec.

T.

R.