

Ellsworth


KANSAS

SECTION 18 TOWNSHIP 17 RANGE 10W

WELL NO. #1 Heitschmidt

COMPANY Walters Drlg. & NCRA

NORTH

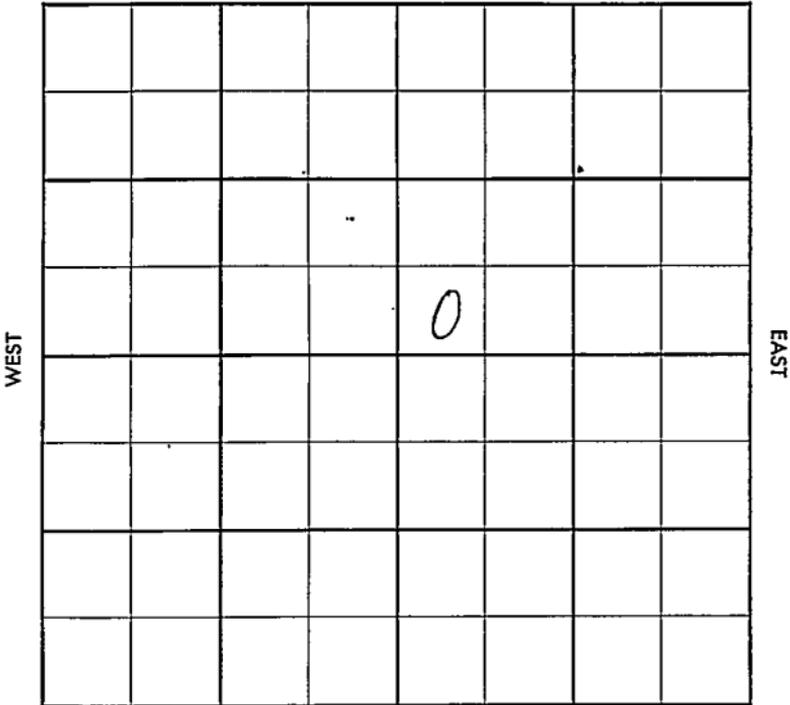

SOUTH

WEST

EAST

Ellsworth **KANSAS**

SEC. 18	TWP. 17	R. LOW
------------	------------	-----------

WELL NO. #1 Heitschmidt FARM

COMPANY Walters Drlg. & NCRA

CONTRACTOR Walters

Kraft-Prusa

_____ Ft. from N. Line	<table border="1" style="width: 100%; height: 100%; border-collapse: collapse; text-align: center;"> <tr><td colspan="7">NORTH</td></tr> <tr><td></td><td></td><td></td><td></td><td></td><td></td><td></td></tr> <tr><td></td><td></td><td></td><td>0</td><td></td><td></td><td></td></tr> <tr><td></td><td></td><td></td><td></td><td></td><td></td><td></td></tr> <tr><td></td><td></td><td></td><td></td><td></td><td></td><td></td></tr> <tr><td></td><td></td><td></td><td></td><td></td><td></td><td></td></tr> <tr><td></td><td></td><td></td><td></td><td></td><td></td><td></td></tr> <tr><td></td><td></td><td></td><td></td><td></td><td></td><td></td></tr> <tr><td colspan="7">SOUTH</td></tr> </table>	NORTH																	0																																							SOUTH						
NORTH	
				0	
SOUTH	
_____ Ft. from S. Line	
_____ Ft. from E. Line	
_____ Ft. from W. Line	

SW SW NE

1956	ELEVATION 1847'	REPORT
------	--------------------	--------

4-4	Comm. 3-22-56 8" @ 286 w/160 DST 2990-3031 op 1 hr. rec. 345' gas, 15' gcm, 0/20" DST 3293-3303 op 1 hr. rec. 18' ocm, 200/20" 5" @ 3301 w/75 WOCT Anh. 606 H. 2864 BL. 2970 L. 2987 A. 3287 TD 3303
5-23	CO 3303 DD 3309 B/ 5 GO / 3 GWPH, 4 hrs. DD 3312, S/ 8 GO, / 2 GW in 1 hr., no inc., DD 3317 FU 1365' oil / 120' wtr., in 13 hrs. P/ 12 BOPD / 28 BWPD. TD 3317'

COMPLETED

County Ellsworth Elev. 1817
 Sec. 18 Twp. 17 Rgs. 10W
 Company Walters Drlg. & NCRA
 FarmName Heitschmidt No. 1

TOPS	DEPTH	LOG	DATUM
Anh.	006		
TP.			
H.	2864		
Tr.			
Dg.			
Bl.	2970		
L.	2987		
K.C.			
B.K.C.			
Ce.			
C.			
M.			
M.			
K.			
Mz.			
Mq.			
V.			
S.			
S.			
A	3287		
R.			
PE.			
G.			
T.D.	3303		

Loc. in Sec. SW SW NE
 Geol. _____
 Contr. Walters
 Pool Kraft-Prusa

FIRST REPORT
 APR 4 '56

Date Comm. 3-22-56
8" @ 286/160 DST 2990-3031 open 1 hr.
rec. 345' gas 15' gem 0/20"
DST 3293-3303 open 1 hr. rec. 18' ocm
200/20" 5" @ 3301/75 WOCT

REC'D I O 1956
 R. J.

Co.
 Lse.
 No.
 Sec.
 T.
 R.

County Ellsworth Elev. 181.7
 Sec. 18 Twp. 17 Rge. LOW
 Company Walters Drls. & NOVA
 Farm Name Weitschmitt No. 1

TOPS	DEPTH	LOG	DATUM	Loc. in Sec.
Ab.	506			SW 1/4
TP				
H	2861			
T				
Dp				
BL	2970			
E	2987			
EC				Geol.
ECI				Cont.
Cc				Walters
C				Pool <u>BIGDOR</u>
M				Kraft-Prusa
N				
K				
Nr				
Ne				
V				
S				
S				
A	3287			
R				
PC				
C				COMPLETE
TD	3303			

Date Comm. 3-22-56 MAY 23 1956
 8" @ 286/160 DST 2990-3031 open 1 hr.
 rec. 3 1/2' gas 15' ocm 0/20"
 DST 3293-3303 open 1 hr. rec. 18' ocm
 200/20" 5" @ 3301/75 WOOT APR 11 '56
 CO 3303 DD 3309' 1 1/4" @ 560 +
 3 GW ph 4 hrs DD 3312 @ 860
 + 2 GW in 1 hr @ no inc DD 3317
 EV 1365' oil + 12' wtr 17 1/2 hrs
 APR 18 '56 POP APR 25 '56 MAY 2 '56 MAY 9 '56 ✓

Co.

Sec.

No.

Sec.

T.

R.

18-17-100

FORM 513-1 SUNRAY

MAY 18 '56

MAY 23 '56

P. 12 Bopdt 28

Bwpd