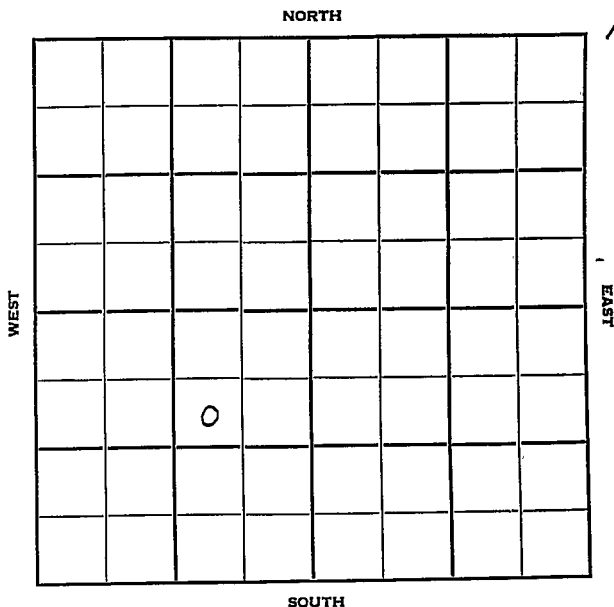


Section 18 Township 17 Range 8 WWell No. # 1 RolfCompany John Lindas

Ellsworth

KANSAS

Sec. 18 Twp. 17 R. 8 W ✓

Well No. # 1 Rolf Farm

John Lindas Company

Contractor


990 Ft. from N. Line

 Ft. from S. Line

990 Ft. from E. Line

 Ft. from W. Line

SW NE SW

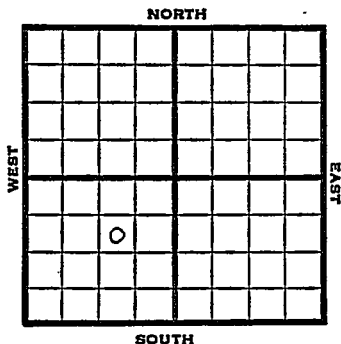

1951

Elev. 1795'

REPORT

4/25

R U R

5/9

Spud 4-26-51

D & A TD 3306'


8" @ 185 Heeb 2759' Br. line 2858'

Lans. 2876' Arb. 3299'

TD 3306' D & A

ABANDONED

J. E. TYRA

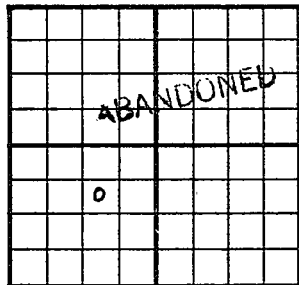County Ellsworth State KansasSec. 18 (Blk.
Twp.) 17 (Sur.
Rge.) 8W Map No.Operator John LindasWell No. 1 Farm RolfElev. 1795 Location SW NE SW990 Ft. From N Line SW990 Ft. From E Line Quarter1st. ReportCompletion MAY 9 1951RemarksSpudding Date 4-26-51Drlg. Data D & A TD 33068" @ 185 Heeb. 2759 Br. lime 2858Lans. 2876 Arb. 3299 TD 3306D & A