


Section 18 Township 17 Range 8W

Well No. #1 Williams

Company Duwe & Farris et al

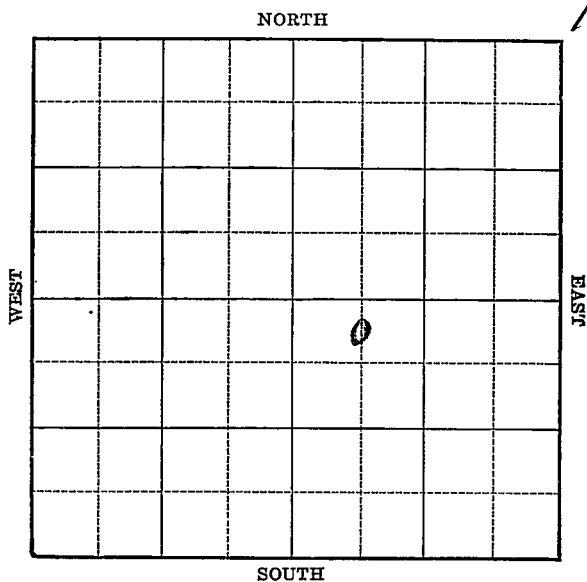

[illegible]

Map No. 45 Sec. 18 Twp. 17 R. 8WWell No. 1 WilliamsDuwe & Farris etal Company

Contractor

FIRST REPORT

C N L NW SE

330 Ft. from N. Line Ft. from S. Line Ft. from E. Line660 Ft. from W. Line

SECTION PLAT

		o	
		.	

GENESEO POOL

Location Rig up Drilling and Remarks:
Derrick

RECORD

Cased in., ft.Sand Gas Oil Total Depth

PRODUCTION

1st 24 hrs. Nat. 1st 24 hrs. after shot Gas Cu. Ft.Dry Hole Abandoned

Date

JUL 17 1940 19S. J. LEWIS Scout

Map No. 45 Sec. 18 Twp. 17 R. 8WWell No. 1 WilliamsDuwe & Farris etal

Company

Contractor

ABANDONED

C N L NW SE

330 Ft. from N. Line

_____ Ft. from S. Line

_____ Ft. from E. Line

660 Ft. from W. Line

GENESEO POOL

SECTION PLAT

Location _____

Rig up _____

Drilling and Remarks:

*CR 83297**Wa Teb.*

RECORD

Cased _____ in., _____ ft.

Sand _____

Gas _____

Oil _____

Total Depth 2311

PRODUCTION

1st 24 hrs. Nat. _____

1st 24 hrs. after shot _____

Gas _____ Cu. Ft.

Dry Hole _____

Abandoned _____

Date

SEP 4 1940 19S. J. LEWIS Scout