

KANSAS

McPherson


FORM 51 5M 10-41 PETROL

Section 18 Township 17 Range 3-W

Well No. #2 Fornberg

Company Carter


NORTH Lindsborg Pool

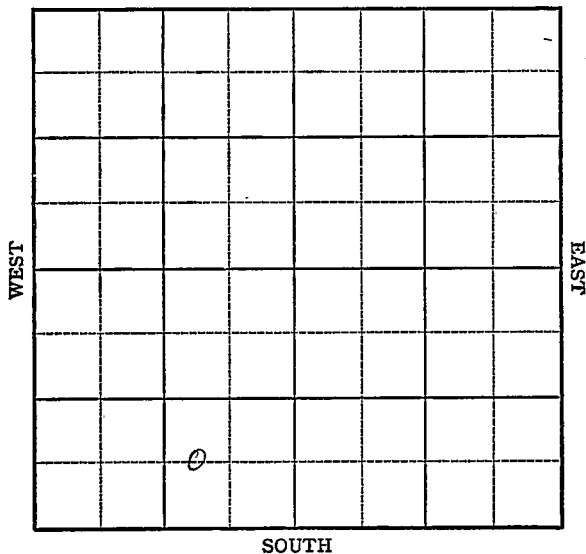

KANSAS McPherson

Sec. 18 Twp. 17 R. 3-WWell No. #2 Fornberg FarmCarter Company

(Lindsborg Pool)

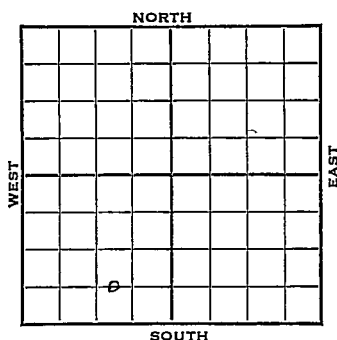 Ft. from N. Line660 Ft. from S. Line990 Ft. from E. Line Ft. from W. LineElev. 1340

1942

REPORT

7/22

Rotary

7/29

10" - 323 Drlg. 1200'

8/5

Drlg. 2655'

8/12

Viola 3362-64 TD 7" @ 3362 Rust

8/19

T.D. 3367- 6500 acid

Swab 6 oil per hr 12 hrs.

8/27

" " " "

9/2

" " " "

9/9

Viola 3362

7" - 3362

6500 acid

T.D. 3367

Pump 277 Pot.

Gravity 36.

COMPLETED

Map No. 42 Sec. 18 Twp. 17 R. 3WWell No. 2 FornbergCarter Company

FIRST REPORT

Contractor

C WL SE SW

 Ft. from N. Line660 Ft. from S. Line990 Ft. from E. Line Ft. from W. Line

SECTION PLAT

LINDSBORG POOL

Location Rig up

Drilling and Remarks:

Rotary

RECORD

Cased in., ft.Sand Gas Oil Total Depth

PRODUCTION

1st 24 hrs. Nat. 1st 24 hrs. after shot Gas Cu. Ft.Dry Hole Abandoned

Date

JUL 22 1942 19 S. J. LEWIS Scout

McPherson

KANSAS

Map No. 42 Sec. 18 Twp. 17 R. 3WWell No. 2 FombergCarter

Company

COMPLETED

Contractor

C WL SE SW

 Ft. from N. Line660 Ft. from S. Line990 Ft. from E. Line Ft. from W. Line

SECTION PLAT

LINDS BORG

Location Rig up

Drilling and Remarks:

*Viola 3362**7" C 3362**16500 Acid**Pump 277 P & S**36 Gr*

RECORD

Cased in., ft.Sand Gas Oil Total Depth 3362

PRODUCTION

1st 24 hrs. Nat. 1st 24 hrs. after shot Gas Cu. Ft.Dry Hole Abandoned

Date

SEP 9 1942 19

S. J. LEWIS Scout