


Section 18 Township 17 Range 3-W

Well No. #1 Carter Fornberg

Company Bay Pet.

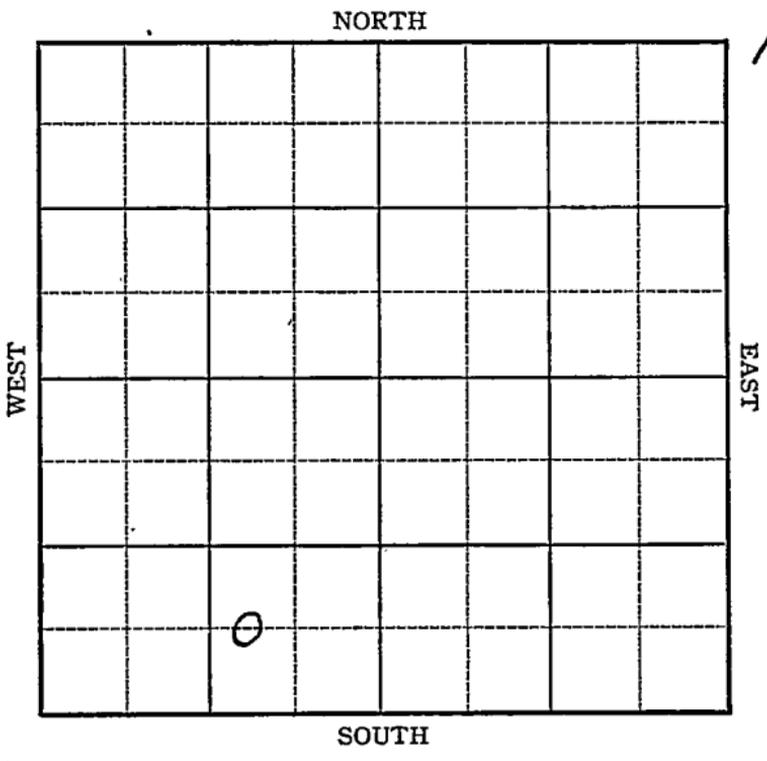

Sec. 18 Twp. 17 R. 3-W

Well No. #1 Carter Fornberg Farm

Bay Pet. Company


 Ft. from N. Line

660 Ft. from S. Line

 Ft. from E. Line

330 Ft. from W. Line

Elev. 1356

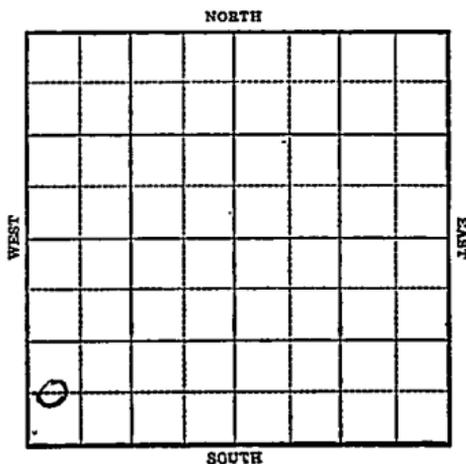

1943 R E P O R T

11/10	Location
11/17	"
11/24	Cellar
12/1	12" @ 120 1" @ 305' Drlg. 915'
12/8	Drlg. 2965'
12-15	Viola 3381'-83' TD Run csg.
12/22	Viola 3385 Corrected 5" @ 3385 TD 3387 RUST
12/29	TD 3388 $\frac{1}{2}$ 350' oil in 48 hrs
1944	
1-5	2000 acid swb 3 oil per hr.
1-12	" "
1/19	" "
1/26	" "
2/2	" "
2/8	" "
2/15	" "
2/23	" "
3/1	" "
3/8	" "

OVER

.1944

3/15 2000 acid 3 oil per hr.


3/22 " " " "

3/29 " " " "

4/5 5" @ 3385
Viola 3385
TD 3409
2000 acid
Pump 180 Pot.
Gravity 36

COMPLETED

675

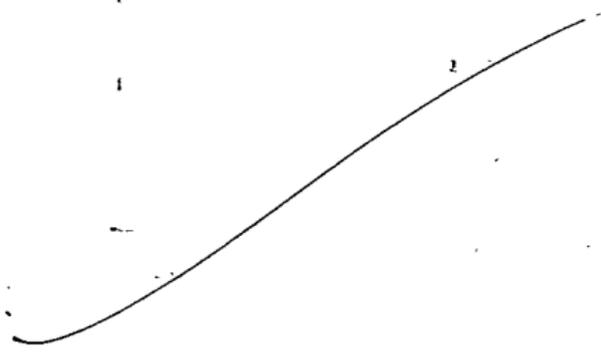

Misc. Small Maps	<i>Orma</i>
Cards	<i>Madge</i>
Tracing	<i>MBH</i>
France Map	<input checked="" type="checkbox"/>
Scarborough Map	<i>MBH</i>
Pierce Map	<i>MBH</i>
Geologic Dept.	
Pierre Plat Book	

KANSAS

Map No. 72 Sec. 18 Twp. 17 R. 3WWell No. 1 Carter HornbergBay Pet. CompanyCOMPLETED Contractor

C W L SW SW

SECTION PLAT

 Ft. from N. Line660 Ft. from S. Line Ft. from E. Line330 Ft. from W. LineLindsborg PoolLocation Rig up

Drilling and Remarks:

*Vista 3385**5" C 3385**2000 acid**Pump. 180 Bx**36 2/4*

RECORD

Cased in., ft.Sand Gas Oil Total Depth 3405

PRODUCTION

1st 24 hrs. Nat. 1st 24 hrs. after shot Gas Cu. Ft.Dry Hole Abandoned

Date

APR 5 1944 19

S. I. LEWIS Scout

Misc. Small Maps

Cards

Tracing

France Map

borough Map

dy Map

ogical Dept

Plat Book

Orma

Manges

75

75