

KANSAS


FORM 51 5M BR1X

McPherson

Section 18 Township 17 Range 3W

Well No. #2 Helberg

Company N. & L. Oil

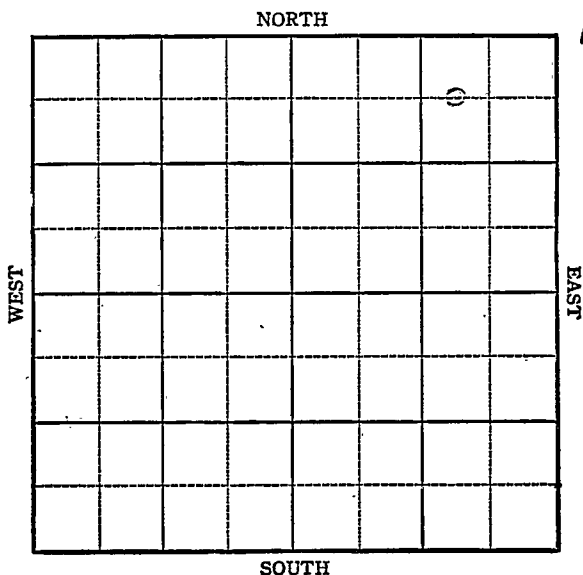

McPherson Co.

FORM 252-A
5M 3-44 PETROL


KANSAS

Lindsborg

Sec. 18 Twp. 17 R. 3WWell No. 2 Helberg FarmM & L Oil Company

C W L NE NE

NORTH

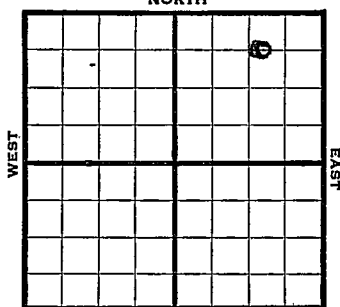660 Ft. from N. Line Ft. from S. Line990 Ft. from E. Line Ft. from W. Line

E.O. 1339

1944

REPORT

9-13

12" 173

Anhy. 325

8" 389

Drilling 1150

9/21

Drlg. 2956

9/28

Viola 3386-89 TD

5" @ 3388' WQC

10/4

TD 3392

10/11

TD 3398

swb 20 oil PH SW

10/18

500 acid

No test

" " "

10/25

11/1

Viola 3386

5" @ 3388

TD 3398'

500' acid

Depth Pot. 981

Grav. 36.0

COMPLETED

KANSAS

Pool Name LindshorgMap No. 42 Sec. 18 Twp. 17 R. 3WWell No. 2 HelbergN. & L. Oil

Company

FIRST REPORT

Contractor

C W L NE NE

SECTION PLAT

660 Ft. from N. Line Ft. from S. Line \990 Ft. from E. Line Ft. from W. Line

			0

McPhersonLocation Rig up

Drilling and Remarks:

12"-173Anhy. 3258"-3891150'

RECORD

Cased in., ft.Sand Gas Oil Total Depth

PRODUCTION

1st 24 hrs. Nat. 1st 24 hrs. after shot Gas Cu. Ft.Dry Hole Abandoned

Date

SEP 13 1944

19

S. J. LEWIS

Scout

Pool Name LindsborgMap No. 42 Sec. 18 Twp. 17 R. 3WWell No. 2 Helberg "A"M & L Oil CompanyCOMPLETED Contractor

C W L NE NE

SECTION PLAT

660 Ft. from N. Line Ft. from S. Line990 Ft. from E. Line Ft. from W. Line

			a

McPherson CountyLocation Rig up

Drilling and Remarks:

Vidla 3386503388500 acailDepth 338886 1/2

RECORD

Cased in., ft.Sand Gas Oil Total Depth 3388

PRODUCTION

1st 24 hrs. Nat. 1st 24 hrs. after shot Gas Cu. Ft.Dry Hole Abandoned

Date

NOV 1 1944 19S. J. LEWIS Scout