

Map No. 42 Sec. 18 Twp. 17 R. 3W

Well No. 1 Hoglund

Luther Mackall Company

FIRST REPORT Contractor

C WL NE NW


660 Ft. from N. Line

_____ Ft. from S. Line

990 Ft. from E. Line

_____ Ft. from W. Line

SECTION PLAT

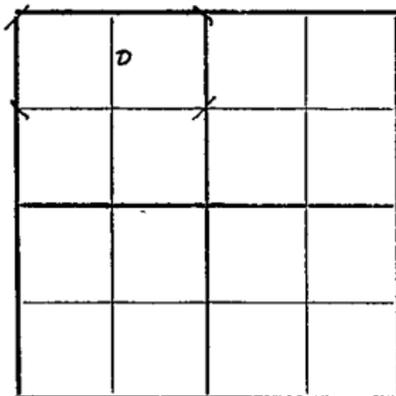

LINDSBORG POOL

Location XX

Rig up _____

Drilling and Remarks:

RECORD

Cased _____ in., _____ ft.

Sand _____

Gas _____

Oil _____

Total Depth _____

PRODUCTION

1st 24 hrs. Nat. _____

1st 24 hrs. after shot _____

Gas _____ Cu. Ft.

Dry Hole _____

Abandoned _____

Date

FEB 11 1942

19

S. J. LEWIS

Scout

McPherson

KANSAS

Map No. 42 Sec. 18 Twp. 17 R. 3WWell No. 1 HoglundLuther Mackall Company**COMPLETED**

Contractor

C WL NE NW

660 Ft. from N. Line Ft. from S. Line990 Ft. from E. Line Ft. from W. Line

SECTION PLAT

	0		

LINDSBORG POOL

Location Rig up

Drilling and Remarks:

*Viola 3380.**5" @ 3380.**2500 acid**Pump 804 Pst.**36 @ Gr*

RECORD

Cased in., ft.Sand Gas Oil Total Depth 3384

PRODUCTION

1st 24 hrs. Nat. 1st 24 hrs. after shot Gas Cu. Ft.Dry Hole Abandoned

Date

MAR 25 1942 19S. J. LEWIS

Scout