

KANSAS


McPherson

FORM 51 5M 10-41 PETROL

Section 18 Township 17 Range 3-W

Well No. #1 Renbeck

Company Dickey

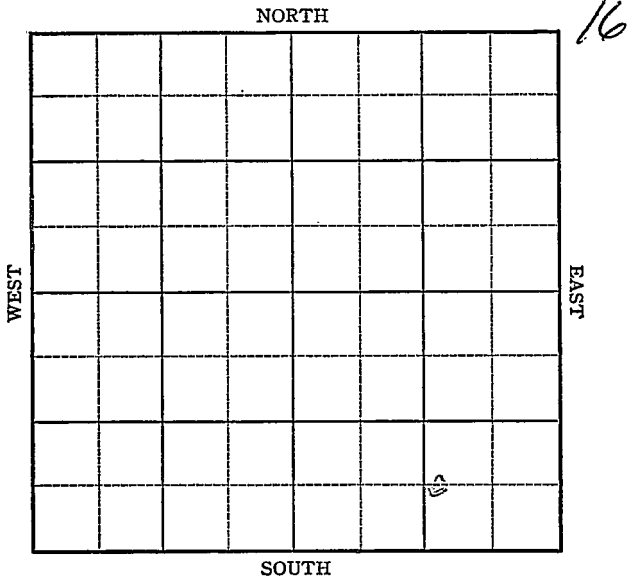

Sec. 18 Twp. 17 R. 3-W

Well No. #1 Renbeck Farm

Dickey Company


Lindsborg Pool

_____ Ft. from N. Line

660 Ft. from S. Line

990 Ft. from E. Line

_____ Ft. from W. Line

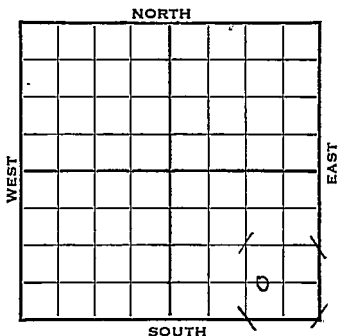

C WL SE SE *E. Sec. 1339*

1942

REPORT

- 12/16 Location
- 12/22 Moming in rotary.
- 12/29 10" - 120 8" - 340 WOC
- 1943
- 1/6 Lans 2360
Drlg. 2806'
- 1/13 Viola 3349
SO 3349-52
Simp. sd. 3482-84 TD
5" casing set 3482' RUST
- 1/20 " " " " "
- 1/27 " " "
- 2/3 Stains 3484-86
HFW 3486 to 88 TD
PB
- 2/10 Plug 3339'
41 shots 3345-55.
7500 gal acid.
- 2/17 Swb 35 Oil
- 2/24 Viola 3349
Simp. 3482
5" @ 3482'
T.D. 3484'
PB ~~3339~~'
40 shots 3349-55
1000 gal acid
Pump 23 bbls oil plus water
Gravity 36

COMPLETED

KANSAS McPhersonMap No. 42 Sec. 18 Twp. 17 R. 3WWell No. 1 RenbeckDickey CompanyFIRST REPORT Contractor

C WL SE SE

SECTION PLAT

 Ft. from N. Line660 Ft. from S. Line990 Ft. from E. Line Ft. from W. Line

LINDSBORG POOL

Location XXXRig up

Drilling and Remarks:

RECORD

Cased in., ft.Sand Gas Oil Total Depth

PRODUCTION

1st 24 hrs. Nat. 1st 24 hrs. after shot Gas Cu. Ft.Dry Hole Abandoned

Date

DEC 16 1942 19S. J. LEWIS Scout

KANSAS
 Map No. 42 Sec. 18 Twp. 17 R. 3W

Well No. 1 Renbeck

Dickey Company

COMPLETED Contractor

C WL S E SE

SECTION PLAT

_____ Ft. from N. Line

660 Ft. from S. Line

990 Ft. from E. Line

_____ Ft. from W. Line

LINDSBORG POOL

Location _____

Rig up _____

Drilling and Remarks:

Viola 3849
Sump 3482
5" @ 3482
Plug Back 3339
400 lbs to 3349-55
10000 Acid
Pump 23 oil + Water

RECORD

Cased _____ in., _____ ft.

Sand _____

Gas _____

Oil _____

Total Depth 3484

PRODUCTION

1st 24 hrs. Nat. _____

1st 24 hrs. after shot _____

Gas _____ Cu. Ft.

Dry Hole _____

Abandoned _____

Date

360 Gr

EEB 24 1943

19

S. J. LEWIS Scout