

Ellsworth


Form 51-5M-11-38-Palace

Section 19 Township 17 Range 9-W

Well No. 2 Mehl

Company Cities Service Oil et al

NORTH Schroeder Pool

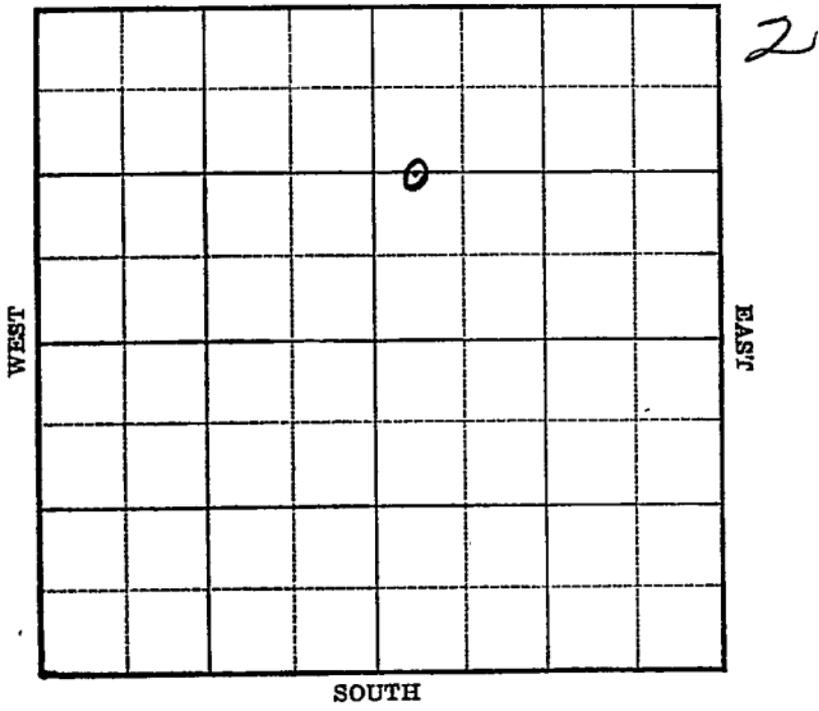

KANSAS

Ellsworth

Sec. 19 Twp. 17 R. 9-W

Well No. #2 Mehl Farm _____

Cities Service Oil et al Company

(Schroeder)


1320 Ft. from N. Line

_____ Ft. from S. Line

_____ Ft. from E. Line

330 Ft. from W. Line

Elev. 1784

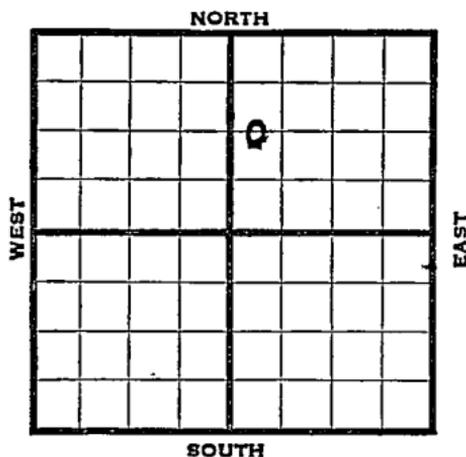

1939	REPORT
4 /26	B.R.R.
5 /5	Surface Hole.
5 /12	8" - 223' Drlg. 3185'
5 /19	Arb. 3229' 5" - 3230'
	T.D. 3240' Saturation in cuttings.
5 /24	Arb. 3229'
	5" - 3230'
	Pump 115 bbls. 8 hours.
	Potential 845 bbls.
	Minumum well 15 bbl s.
	COMPLETED

Map No. 45 Sec. 19 Twp. 17 R. 9W

Well No. 2 Mehl

Cities Service Oil Etal Company

Contractor

SECTION PLAT

C W L N E

1320 Ft. from N. Line

_____ Ft. from S. Line

_____ Ft. from E. Line

330 Ft. from W. Line

Schroeder Pool

		0	

Location _____

Rig up _____

Drilling and Remarks:

BRR

RECORD

Cased _____ in., _____ ft.

Sand _____

Gas _____

Oil _____

Total Depth _____

PRODUCTION

1st 24 hrs. Nat. _____

1st 24 hrs. after shot _____

Gas _____ Cu. Ft.

Dry Hole _____

Abandoned _____

Date

4-26 19 30 H. D. H. Scout

[Handwritten signature]

Ellsworth **KANSAS**

Map No. 45 Sec. 19 Twp. 17 R. 9W

Well No. 2 Mehl

Cities Service Oil Company

Contractor

COMPLETED

SECTION PLAT

C W L N E
1320 Ft. from N. Line

_____ Ft. from S. Line

_____ Ft. from E. Line

330 Ft. from W. Line

		0	

SCHROEDER POOL

Location _____

Rig up _____

Drilling and Remarks:

*Co. 3229
5" @ 3230
Pump 115-8 hrs
P & 845
Minimum Well
15 1/2*

RECORD

Cased _____ in., _____ ft.

Sand _____

Gas _____

Oil _____

Total Depth 3239

PRODUCTION

1st 24 hrs. Nat. _____

1st 24 hrs. after shot _____

Gas _____ Cu. Ft.

Dry Hole _____

Abandoned _____

Date

MAY 24 1939 19

S. J. LEWIS

Scout