



Map No.            Sec. 19 Twp. 17 R. 9W

KANSAS

Well No. 1 - Splitter Farm             
Smith - Ash & Phillips Company


           Ft. from N. Line

330 Ft. from S. Line

           Ft. from E. Line

330 Ft. from W. Line

Elev. 1776

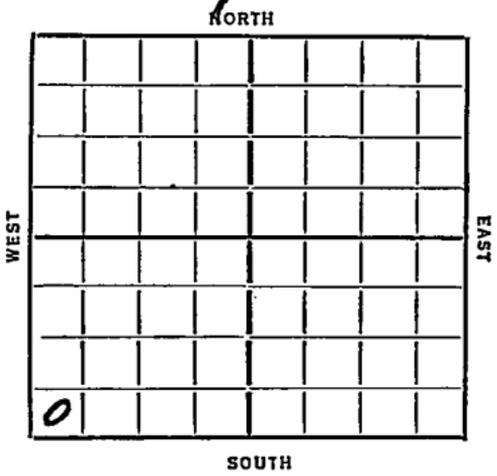

REPORT

Date  
 1936  
 1/29  
 2/7  
 2/14  
 2/21  
 2/28  
 3/6  
 3/18

Blkg Rig  
Spun 60° & SD  
Blg 465 15" 77  
" 1510 12" 497  
" 7040 10" 1854  
" 2525 Blg 493  
Bl 3305  
TD 3330  
HFW 3325-30  
D. A.

ABANDONED

Map No. 45 Sec. 19 Twp. 17 R. 9W

Well No. 1 - Splitter

Smith - Ash + Phillips Company

Contractor

FIRST REPORTS

SECTION PLAT

..... Ft. from N. Line

330 Ft. from S. Line

..... Ft. from E. Line

330 Ft. from W. Line

0			

Location.....

Rig up.....

Drilling and Remarks:

Bad Rig

RECORD

Cased..... in., ..... ft.

Sand.....

Gas.....

Oil.....

Total Depth.....

PRODUCTION

1st 24 hrs. Nat.....

1st 24 hrs. after shot.....

Gas..... Cu. Ft.

Dry Hole.....

Abandoned.....

Date

1-29-36 192.....

ORVAL MANNSCHRECK

Scout

Ellsworth

Form 26-1M Bks.-9-28

KANSAS

Map No. 45 Sec. 19 Twp. 17 R. 9W

Well No. 1 - Splitter

Smith, Ash, & Phillips Company

Contractor

COMPLETED

SECTION PLAT

Ft. from N. Line

330 Ft. from S. Line

Ft. from E. Line

330 Ft. from W. Line

0			

Location

Rig up

Drilling and Remarks:

hfw 3325-30

Q+A

RECORD

Cased in, ft.

Sand Sil 3305

Gas

Oil

Total Depth 3330

PRODUCTION

1st 24 hrs. Nat.

1st 24 hrs. after shot

Gas Cu. Ft.

Dry Hole

Abandoned

Date

MAR 18 1936

ORVAL MANNSCHRECK

Scout