


Section 19 Township 17 Range 9-W

Well No. #3 Splitter

Company C. E. Ash et al

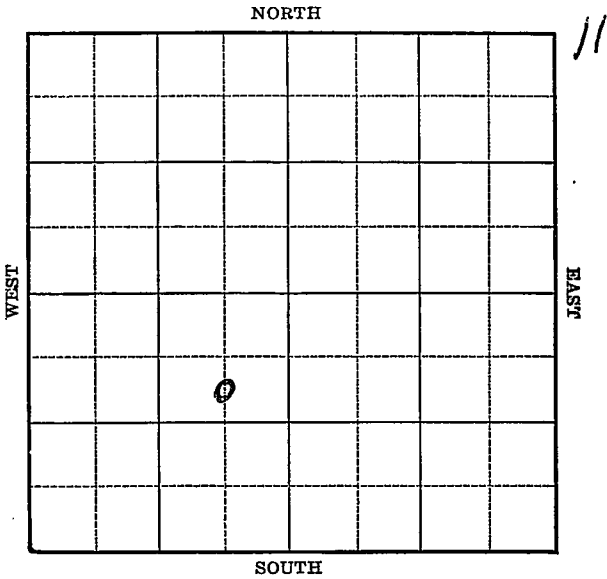

Sec. 19 Twp. 17 R. 9-W

Well No. #3 Splitter Farm

C. E. Ash et al Company

(Schroeder)


990 Ft. from N. Line

_____ Ft. from S. Line

660 Ft. from E. Line

_____ Ft. from W. Line

Elev. 1782

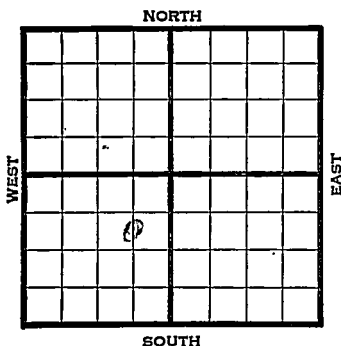

1941

REPORT

2/12

Location

2/20

"

2/27

Derri ck.

3/6

"

3/13

8" - 180' Anhy 463'

Drlg. 2025'

3/20

Arb. 3224-27' T.D.

5" - 3225' RUST.

3/27

" " "

4/2

" " "

4/10

T.D. 3247' 1950' oil 4½ hours.

4/18

Swab 10 bbls. per hour.

500 acid. Swab 22 bbls. per hour.

2000 acid. Swab 29 bbls. per hour.

OVER

1941

4/23

Arb. 3224'

5" - 3225'

T.D. 3247'

2000 acid.

Depthograph potential 825 bbls.

40.1 Gravity

COMPLETED

Map No. 45 Sec. 19 Twp. 17 R. 9WWell No. 3 Splitter

C. E. Ash et al

Company

FIRST REPORT

Contractor

C S L NE SW

SECTION PLAT990 Ft. from N. Line

_____ Ft. from S. Line

660 Ft. from E. Line

_____ Ft. from W. Line

SCHROEDER POOL

Location X

Rig up _____

Drilling and Remarks:

RECORD

Cased _____ in., _____ ft.

Sand _____

Gas _____

Oil _____

Total Depth _____

PRODUCTION

1st 24 hrs.-Nat. _____

1st 24 hrs. after shot _____

Gas _____ Cu. Ft.

Dry Hole _____

Abandoned _____

Date

FEB 12 1941

19

S. J. LEWIS Scout

Misc. Small Maps

Cards

Tracing

France Map

Coarborough Map

Moody Map

Geological Sect.

Moody Map Book

Map No. 45 Sec. 19 Twp. 17 R. 9W

Well No. 3 Splitter

C. E. Ash etal Company

COMPLETED Contractor

C S L N E S W

SECTION PLAT

990 Ft. from N. Line

_____ Ft. from S. Line

660 Ft. from E. Line

_____ Ft. from W. Line

SCHROEDER POOL

Location _____

RECORD

Rig up _____

Drilling and Remarks:

Cased _____ in., _____ ft.

Sand _____

Gas _____

Oil _____

Total Depth 3247

Ac 8224

5" 8225

2000 acial

Depth 825

PRODUCTION

1st 24 hrs. Nat. _____

1st 24 hrs. after shot _____

Gas _____ Cu. Ft.

Dry Hole _____

Abandoned _____

40' Gr.

Date

APR 23 1941 19 _____ S. J. LEWIS Scout

Misc. Small Maps

Cards

Tracing

France Map

Swarborough Map

Coaly Map

Geological Dept.

Moody Flat Book

Handwritten signatures and scribbles in cursive script, including the name 'DAN' and other illegible marks, overlapping the printed text.