KANSAS


FORM 51 IOM 12-46 PETROL

Ellsworth county

Section 19 Township 17 Range 9-W

Well No. #6, Mehl

Company Cities Service etal

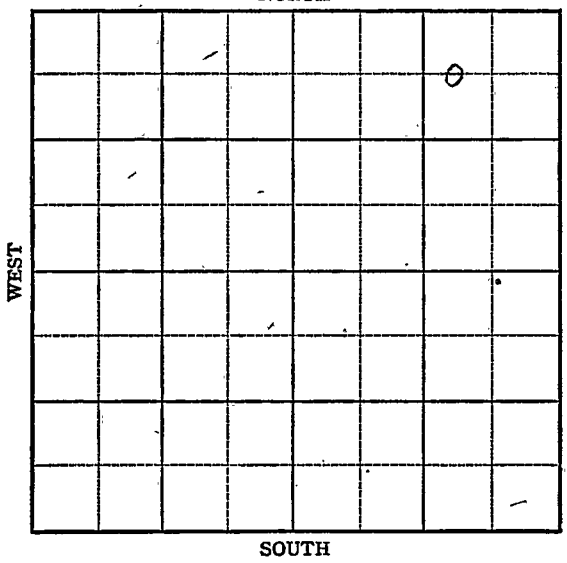

FORM 252-A
5M 8-45 PETROL

KANSAS

Ellsworth County

Sec. 19 Twp. 17 R. 9-W

Well No. 6 Mehl Farm

Cities Service etal Company

Schroeder Pool


660 Ft. from N. Line

_____ Ft. from S. Line

990 Ft. from E. Line

_____ Ft. from W. Line

C W L NE NE

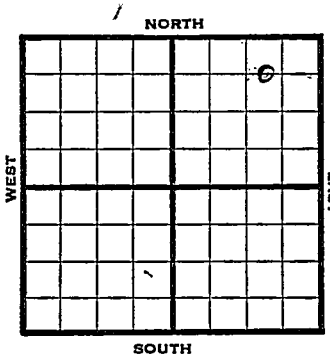

1947	REPORT Elev. 1786
1/15	8" @ 250' WOC
1/21	Drlg 3037'
1/30	Lans 2801' Simp Sd 3238 Arbuckle 3246-47 TD 5" @ 3246 RUST
2/5	Arb 3243' Corrected 5" @ 3243' TD 3245' Pump 79 oil & 123 W in 24 hrs
2/12	" " "
2/19	Pump 53 bbls oil & 209 W in 24 hrs
2/26	" " "
3/4	Pump " "
3/11	TD 3245'

OVER

3/19 Arb 3243
5" @ 3243
Pump 30 oil & 130 W Pot
Grav. 41
TD 3245'

COMPLETED

Form 26 200 Bks. 10-46 Petrol KANSAS Schroeder Pool

Kansas

Map No. 11 Sec. 19 Twp. 17 R. 9W

Well No. 6 Mehl

Cities Service etal. Company

FIRST REPORT Contractor

C W L NE NE


660 Ft. from N. Line

Ft. from S. Line

990 Ft. from E. Line

Ft. from W. Line

SECTION PLAT

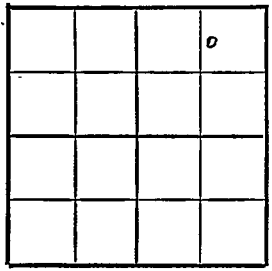

Ellsworth County

Location

Rig up

Drilling and Remarks:

8" @ 250 WOC

RECORD

Cased in., ft.

Sand

Gas

Oil

Total Depth

PRODUCTION

1st 24 hrs. Nat.

1st 24 hrs. after shot


Gas Cu. Ft.

Dry Hole

Abandoned

Date

JAN 15 1947 19 S. J. LEWIS Scout

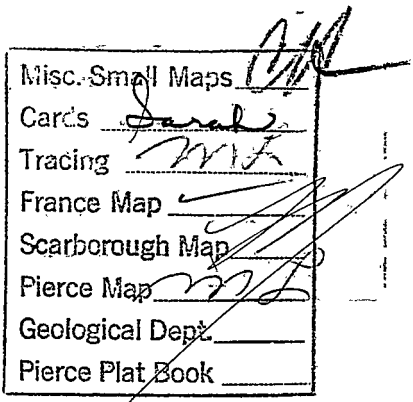
Misc. Small Maps
Cards
Tracing
France Map
Scarborough Map
Pierce Map
Geological Dept.
Pierce Plat Book

Form 26 200 Bks. 10-46 Petrol KANSAS Schroeder Pool

Kansas

Map No. 4 J Sec. 19 Twp. 17 R. 9W

Well No. 6 Mehl


Cities Service etal. Company

COMPLETE Contractor

C W L NE NE

E.L. 1786

SECTION PLAT

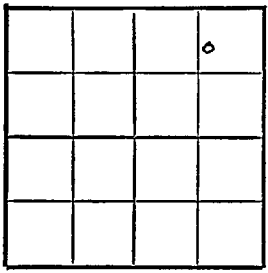

660 Ft. from N. Line

_____ Ft. from S. Line

990 Ft. from E. Line

_____ Ft. from W. Line

Ellsworth County

Location

Rig up

Drilling and Remarks:

Ran 3243

5" @ 3243

Pump 80 bbl +

80 W Pd

41 Gr

RECORD

Cased ____ in., ____ ft.

Sand

Gas

Oil

Total Depth 3245

PRODUCTION

1st 24 hrs. Nat.

1st 24 hrs. after shot

Gas ____ Cu. Ft.


Dry Hole

Abandoned

Date

MAR 19 1947

19 S. LEWIS Scout

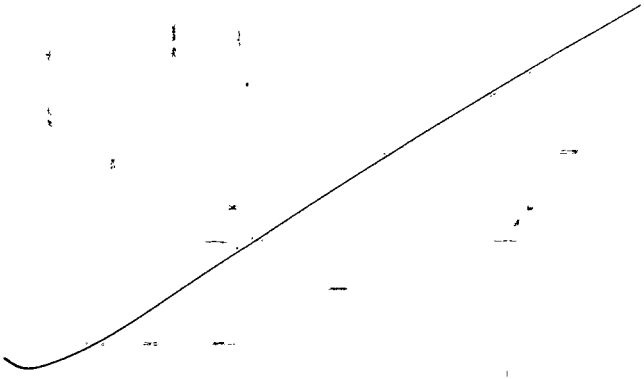

Misc. Small Maps
Cards
Tracing
France Map
Scarborough Map
Pierce Map
Geological Dept.