

KANSAS

Form 51-5M-7-39-Palace


Ellsworth

Section 19 Township 17 Range 9-W

Well No. #2 Splitter

Company Comet Drlg.

NORTH **Schroeder Pool**

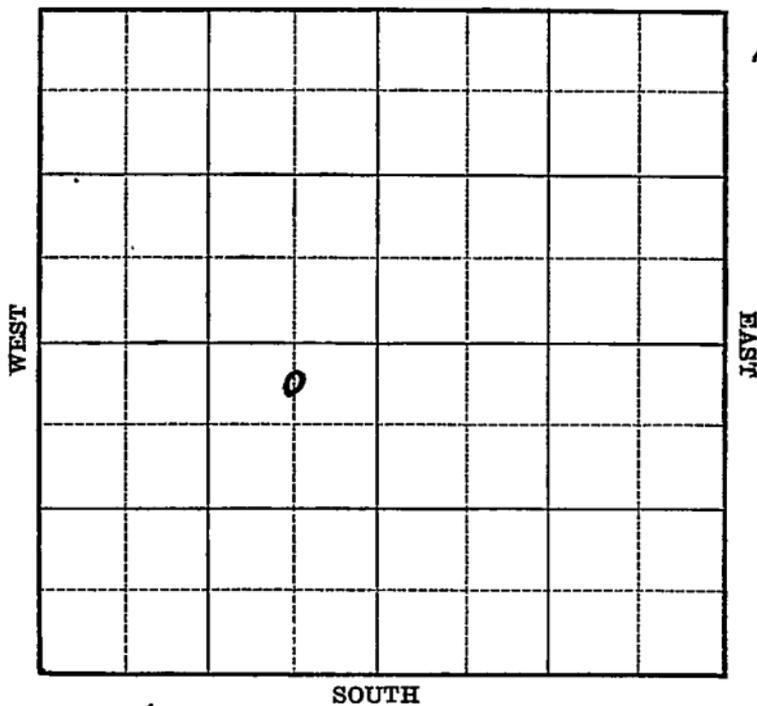

KANSAS Ellsworth

FORM 252-A 5M 2-40

Sec. 19 Twp. 17 R. 9-W

Well No. #2 Splitter Farm _____

Comet Drilling Company _____

(Schroeder)


330 Ft. from N. Line

_____ Ft. from S. Line

660 Ft. from E. Line

_____ Ft. from W. Line

Elev. 1784

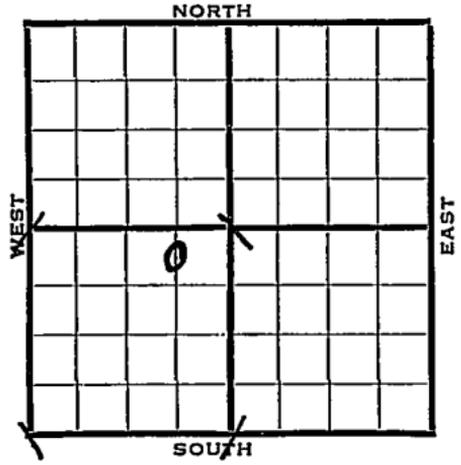

	REPORT
1940	
6/29	Derrick.
6/27	10" - 188' Drlg. 250'
7/3	Drlg. 2650'
7/11	Lansing 2915' Arb. 3220-30' TD
	5" - 3220' RUST.
7/18	" " "
7/25	1400' fluid 9 hours.
8/2	1000 acid. 3000 acid.
	Testing.
8/8	"
8/14	"
8/21	Arb. 3220'
	5" - 3220'
	T.D. 3230'
	3000 acid.
	Depthograph potential 3278 bbls.
	Maximum 3000 bbls.
	COMPLETED

Map No. 45 Sec. 19 Twp. 17 R. 9W

Well No. 2 Splitter

Comet Drilling Company

Contractor

FIRST REPORT

C N L NE SW

330 Ft. from N. Line


_____ Ft. from S. Line

660 Ft. from E. Line

_____ Ft. from W. Line

Schroeder Pool

SECTION PLAT

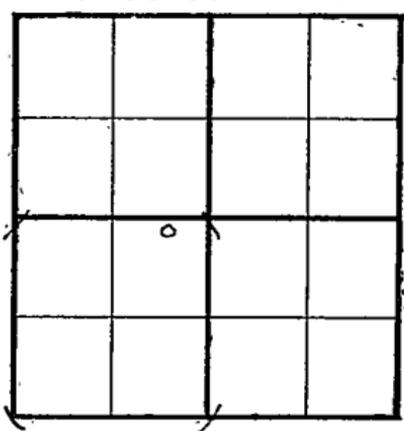

Location _____

Rig up _____

Drilling and Remarks:

Derrick

RECORD

Cased _____ in., _____ ft.

Sand _____

Gas _____

Oil _____

Total Depth _____

PRODUCTION

1st 24 hrs. Nat. _____

1st 24 hrs. after shot _____

Gas _____ Cu. Ft.

Dry Hole _____

Abandoned _____

Date

JUN 19 1940

S. J. LEWIS Scout

Map No. 45 Sec. 19 Twp. 17 R. 9W

Well No. 2 Splitter

Comet Drilling Company

Contractor

COMPLETED

C N L NE SW

330 Ft. from N. Line

_____ Ft. from S. Line

660 Ft. from E. Line

_____ Ft. from W. Line

SCHROEDER POOL

SECTION PLAT

	o		

Location _____

Rig up _____

Drilling and Remarks:

Cor & 3220

5" @ 3220

3000 acid

Geothropic Rd.

3278

Map 3000

RECORD

Cased _____ in., _____ ft.

Sand _____

Gas _____

Oil _____

Total Depth 3230

PRODUCTION

1st 24 hrs. Nat. _____

1st 24 hrs. after shot _____

Gas _____ Cu. Ft.

Dry Hole _____

Abandoned _____

Date

AUG 21 1940 19

S. J. LEWIS Scout