


Map No. **KANSAS** Sec. 19 Twp. 17 R. 9^w
 Well No. 1 Heffler Farm
Smith & Ash Company

330 Ft. from N. Line
 _____ Ft. from S. Line
 _____ Ft. from E. Line
330 Ft. from W. Line

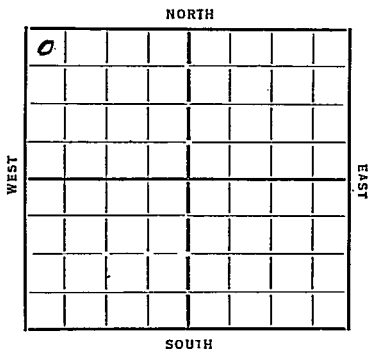

Date	REPORT
9/19	Location
9/27	Spud
10/4	Dlg 1140 15" 141 12" 517
10/11	" 2012 10" 1698
10/18	" 2450
10/25	" 2700 8" 2605
11/1	" 2788
11/8	Siliceous 3275 5" 3269
	3283 T1) 2200' oil thro 51)
11/14	Siliceous 3275 T1) 3283
	629 Bbls Net.

COMPLETED

Edwards KANSAS

Map No. 45 Sec. 19 Twp. 17 R. 9W

Well No. 1-Weffler

Smith & Ash Company

Contractor

SECTION PLAT

330 Ft. from N. Line
Ft. from S. Line
Ft. from E. Line
330 Ft. from W. Line

0			

FIRST REPORTS

Location ✓

Rig up

Drilling and Remarks:

RECORD

Cased _____ in., _____ ft.

Sand _____

Gas _____

Oil _____

Total Depth _____

PRODUCTION

1st 24 hrs. Nat. _____

1st 24 hrs. after shot _____

Gas _____ Cu. Ft.

Dry Hole _____

Abandoned _____

Date

9-18-34 19

ORVAL MANNSCHRECK Scout

Map No. 45 Sec. 19 Twp. 17 R. 9WWell No. 1 - WellerSmith & Ash Company

Contractor

COMPLETED

SECTION PLAT

330 Ft. from N. Line

..... Ft. from S. Line

..... Ft. from E. Line

330 Ft. from W. Line

0			

Location.....

Rig up.....

Drilling and Remarks:

629 lbs
natural

RECORD

Cased..... in., ft.

Sand Silicious 3272

Gas.....

Oil.....

Total Depth 3283

PRODUCTION

1st 24 hrs. Nat.....

1st 24 hrs. after shot.....

Gas..... Cu. Ft.

Dry Hole.....

Abandoned.....

Date

11-14-34 192

ORIGINAL MANUSCRIPT

Scout