


Section 19 Township 17 Range 9-W

Well No. #3 Wessler

Company Cities Service Oil

Schroeder Pool

NORTH

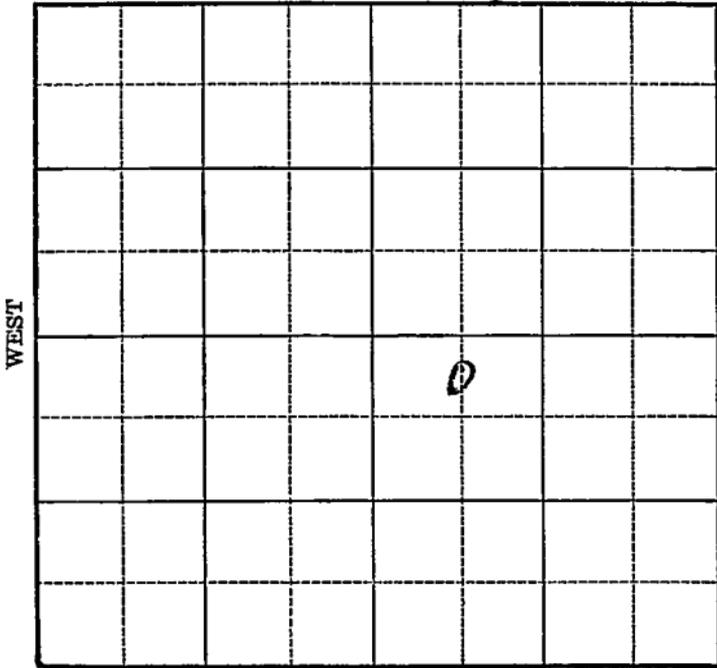

SOUTH

Sec. 19 Twp. 17 R. 9-W

Well No. #3 Wesseler Farm _____

Cities Service Oil Company

(Schroeder)


330 Ft. from N. Line

_____ Ft. from S. Line

_____ Ft. from E. Line

660 Ft. from W. Line

Elev. 1779

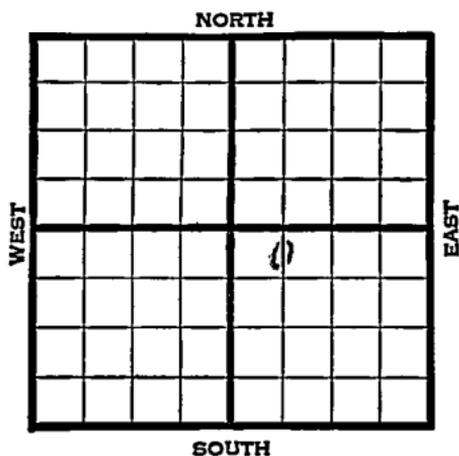

1940	REPORT
10/23	Location
10/31	8" - 209' WOC.
11/6	Drlg. 3035'
11/14	Arb. 3212 ³²¹⁷ ' 5" - 3212 ³²¹⁷ '
	T.D. 3213' RUST.
11/21	Arb. 3217' (Corrected)
	5" - 3217' T.D. 3236'
	5000 acid. On potential.
11/26	Arb. 3217'
	5" - 3217'
	T.D. 3236'
	5000 acid.
	Depthograph potential 7204 bbls.
	Maximum 3000 bbls.
	38.2 gravity
	COMPLETED

Map No. 45 Sec. 19 Twp. 17 R. 9W

Well No. 3 Wesseler

Cities Service Oil Company

Contractor

FIRST REPORT

SECTION PLAT

C N L NW SE

330 Ft. from N. Line

_____ Ft. from S. Line

_____ Ft. from E. Line

660 Ft. from W. Line

		o	

SCHROEDER POOL

Location X

Rig up _____

Drilling and Remarks:

RECORD

Cased _____ in., _____ ft.

Sand _____

Gas _____

Oil _____

Total Depth _____

PRODUCTION

1st 24 hrs. Nat. _____

1st 24 hrs. after shot _____

Gas _____ Cu. Ft.

Dry Hole _____

Abandoned _____

Date

OCT 23 1940₁₉

S. J. LEWIS

Scout

Map No. 45 Sec. 19 Twp. 17 R. 9W

Well No. 3 Wesseler

Cities Service Oil Company

Contractor

COMPLETED

C N L NW SE

330 Ft. from N. Line

_____ Ft. from S. Line

_____ Ft. from E. Line

660 Ft. from W. Line

SECTION PLAT

		o	

SCHROEDER POOL

Location _____

Rig up _____

Drilling and Remarks:

Cr. & 3217

5" @ 3217

5000 Acid

Sept 18 1940 7204

May 3000

382 Gr.

RECORD

Cased _____ in., _____ ft.

Sand _____

Gas _____

Oil _____

Total Depth 3236

PRODUCTION

1st 24 hrs. Nat. _____

1st 24 hrs. after shot _____

Gas _____ Cu. Ft.

Dry Hole _____

Abandoned _____

Date

NOV 26 1940₁₉

S. J. LEWIS Scout