

KANSAS


Ellsworth

FORM 51 5M PETROL

Section 19 Township 17 Range 9 W

Well No. #4 Splitter

Company C. E. Ash & Phillips

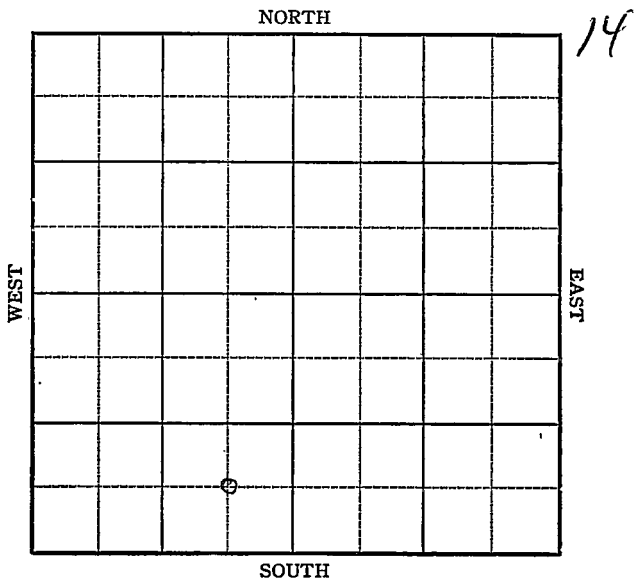

Sec. 19 Twp. 17 R. 9-W

Well No. #4 Splitter Farm
C. E. Ash & Phillips Company


_____ Ft. from N. Line

660 Ft. from S. Line

660 Ft. from E. Line

_____ Ft. from W. Line

Elev. 1781

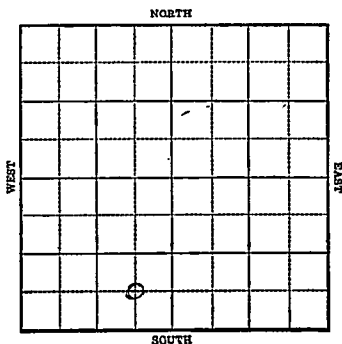

1943

R E P O R T

| | |
|-------|--------------|
| 12/1 | Location. |
| 12/8 | Rotary |
| 12-15 | " |
| | " |
| 12/22 | " |
| 12/29 | Surface hold |
| 1944 | |
| 1-5 | 8" @ 204 |
| | Drlg 1500' |
| 1-12 | " |
| 1/19 | Cong 3222 |
| | Simp Sd 3245 |
| | Arb 3257 |
| | TD 3286' |
| | Water |

ABANDONED

KANSAS
 Map No. Sec. 19 Twp. 17 R. 9W

Well No. 4 Splitter

C. E. Ash & Phillips Company

FIRST REPORT

Contractor

C SE SW

SECTION PLAT

| | | | |
|--|--|--|--|
| | | | |
| | | | |
| | | | |
| | | | |
| | | | |

_____ Ft. from N. Line

660 Ft. from S. Line

660 Ft. from E. Line

_____ Ft. from W. Line

Schroeder Pool

Location X

Rig up _____

Drilling and Remarks:

RECORD

Cased _____ in., _____ ft.

Sand _____

Gas _____

Oil _____

Total Depth _____

PRODUCTION

1st 24 hrs. Nat. _____

1st 24 hrs. after shot _____

Gas _____ Cu. Ft.

Dry Hole _____

Abandoned _____

Date

DEC 1 1943 19

S. J. LEWIS

Scout

KANSAS
Map No. 5

Sec. 19 Twp. 17 R. 9W

Well No. 4 Splitter

C. E. Ash & Phillips Company

ABANDONED Contractor

C SE SW

SECTION PLAT

| | | | |
|--|---|--|--|
| | | | |
| | | | |
| | | | |
| | 0 | | |

_____ Ft. from N. Line

660 Ft. from S. Line

660 Ft. from E. Line

_____ Ft. from W. Line

Schroeder Pool

Location _____

Rig up _____

Drilling and Remarks:

*Core 3222
Core 3245
Core 3257
Water*

RECORD

Cased _____ in., _____ ft.

Sand _____

Gas _____

Oil _____

Total Depth 3286

PRODUCTION

1st 24 hrs. Nat. _____

1st 24 hrs. after shot _____

Gas _____ Cu. Ft.

Dry Hole _____

Abandoned _____

Date

JAN 19 1944

19

S. J. LEWIS Scout