

KANSAS

Ellsworth


FORM 51 IOM 12-46 PETROL

Section 19 Township 17 Range 9-W

Well No. 4 Wesseler

Company Sohio et al

Stoltenberg Pool NORTH

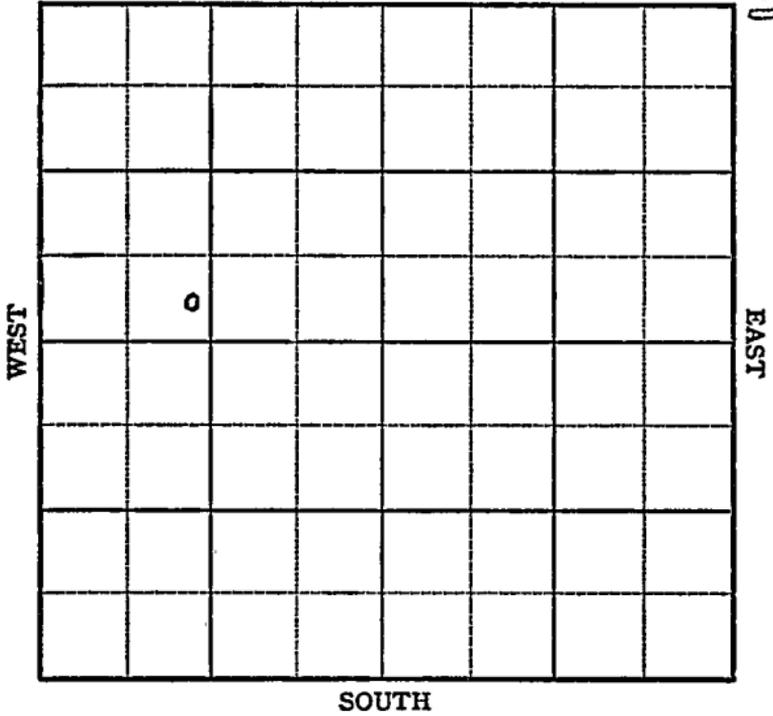

Sec. 19 Twp. 17 R. 9W

Well No. #4 Wessler Farm

Sohio et al Company
Stoltenberg


Ft. from N. Line

330 Ft. from S. Line

Ft. from E. Line

1310 Ft. from W. Line

SE SW NW

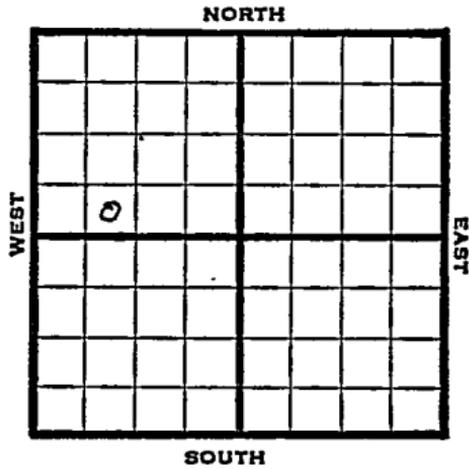

1947 Elev. 1789 REPORT

9/17 10" @ 202'
WOC

9/24 Drlg. 2915'

10/1 Lansing 2917
Bimp. 8251
Arbuckle 3269
TD 33288

ABANDONED

Map No. 45 Sec. 19 Twp. 17 R. 9W

Well No. 4 Wessler

Schio et al. Company

ABANDONED Contractor

SE SW NW

E 11789
SECTION PLAT

_____ Ft. from N. Line

330 Ft. from S. Line

_____ Ft. from E. Line

1310 Ft. from W. Line

| | | | |
|--|--|--|--|
| | | | |
| | | | |
| | | | |
| | | | |

Ellsworth County

Location _____

Rig up _____

Drilling and Remarks:

Lease 2917
Dump 8257
Cr 8269

RECORD

Cased _____ in., _____ ft.

Sand _____

Gas _____

Oil _____

Total Depth 3285

PRODUCTION

1st 24 hrs. Nat. _____

1st 24 hrs. after shot _____

Gas _____ Cu. Ft.

Dry Hole _____

Abandoned _____

Date

OCT 1 1947 19

S. J. LEWIS Scout