

KANSAS

FORM 51 5M 4-41 PETROL


Ellsworth

Section 19 Township 17 Range 9-W

Well No. #5 Wesseler

Company Cities Service Oil et al

NORTH Schroeder pool

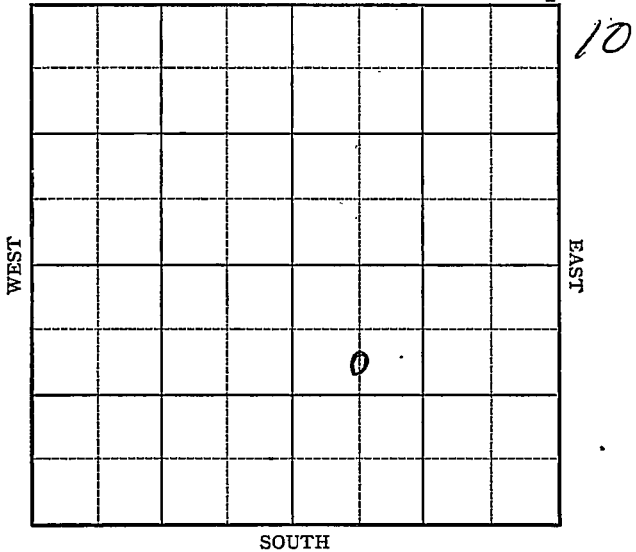

Map No. 45 Sec. 19 Twp. 17 R. 9WWell No. 5 WesselerCities Service Oil ^{etal} CompanyFIRST REPORT

Contractor

SECTION PLAT

C S L NW SE

990 Ft. from N. Line

_____ Ft. from S. Line

_____ Ft. from E. Line

660 Ft. from W. Line

SCHROEDER POOL

		o	

Location _____

Rig up _____

Drilling and Remarks:

8" - 215

Drlg. 1970

RECORD

Cased _____ in., _____ ft.

Sand _____

Gas _____

Oil _____

Total Depth _____

PRODUCTION

1st 24 hrs. Nat. _____

1st 24 hrs. after shot _____

Gas _____ Cu. Ft.

Dry Hole _____

Abandoned _____

Date

MAY 14 1941 19

S. J. LEWIS Scout

Map No. 45 Sec. 19 Twp. 17 R. 9WWell No. 5 WesselerCities Service Oil etal Company~~COMPLETED~~

Contractor

SECTION PLAT

C S L NW SE

990 Ft. from N. Line

_____ Ft. from S. Line

_____ Ft. from E. Line

660 Ft. from W. Line

SCHROEDER POOL

Location _____

Rig up _____

Drilling and Remarks:

*Cr 7322.**5" @ 3222.**3000 acial**Ech Rd 1414**405 Gr*

RECORD

Cased _____ in., _____ ft.

Sand _____

Gas _____

Oil _____

Total Depth 8289

PRODUCTION

1st 24 hrs.-Nat. _____

1st 24 hrs. after shot _____

Gas _____ Cu. Ft.

Dry Hole _____

Abandoned _____

Date

JUN 4 1941 19S. J. LEWIS Scout