


KANSAS

Ellsworth

Section 19 Township 17 Range 9W

Well No. 6 Wessler

Company Cities Service et al

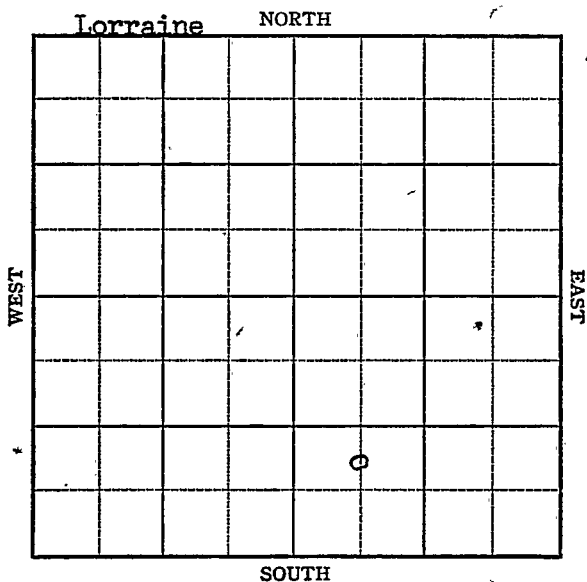

15

KANSAS
Ellsworth ✓

Sec. 19 Twp. 17 R. 9W

Well No. #6 Wesseler Farm

Cities Service et al Company


Lorraine
Ft. from N. Line

999 Ft. from S. Line

Ft. from E. Line

660 Ft. from W. Line

C N L SW SE

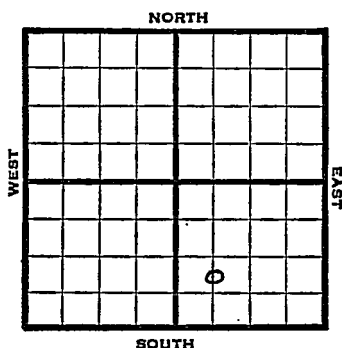

1947 Elev. 1775' REPORT

4/2	Location.
4/9	8" @ 242 WOC
4/15	Arbuckle 3225'-35' TD Run 5"
4/23	5" @ 3227' RUST
4/29	TD 3206' 850' oil 11 hrs 500 acid
5/7	1000 Acid Pump 95' oil in 6 hrs
5/15	" "
5/20	" "
5/27	" " " " " "
6/4	Arb. 3225' 5" @ 3227' 500 Acid. Pump 128 Pot 47.0 Gr. TD 3236'

COMPLETED

Map No. K45 Sec. 19 Twp. 17 R. 9W

Well No. 6 Wesseler

Cities Service etal. Company

FIRST REPORT Contractor

6 N L SW SE

SECTION PLAT

		o	

 Ft. from N. Line

990 Ft. from S. Line

 Ft. from E. Line

660 Ft. from W. Line

Ellsworth County

Location X

Rig up

Drilling and Remarks:

RECORD

Cased in., ft.

Sand

Gas

Oil

Total Depth

PRODUCTION

1st 24 hrs. Nat.

1st 24 hrs. after shot

Gas Cu. Ft.

Dry Hole

Abandoned

Date

APR 2 1947 19 S. J. LEWIS Scout

Map No. 45 Sec. 19 Twp. 17 R. 9W

Well No. 6 Wessler

Cities Service etal. Company

COMPLETE

Contractor

C N L SW SE

E. 1775
SECTION PLAT

		6	

 Ft. from N. Line

990 Ft. from S. Line

 Ft. from E. Line

660 Ft. from W. Line

Ellsworth County

RECORD

Location

Cased in., ft.

Rig up

Sand

Drilling and Remarks:

Gas

Oil

Total Depth 3206

PRODUCTION

1st 24 hrs. Nat.

1st 24 hrs. after shot

Gas Cu. Ft.

Dry Hole

Abandoned

Date

JUN 4 1947 19 S. J. LEWIS Scout