

Section 19 Township 17 Range 9W

Well No. 9 Wessler

Company Cities Service et al

Lorraine

NORTH

WEST

EAST

SOUTH

							0

16

Sec. 19 Twp. 17 R. 9-W ✓

Well No. #9 Wesseler Farm

Cities Service etal Company

Lorraine


 Ft. from N. Line

330 Ft. from S. Line

330 Ft. from E. Line

 Ft. from W. Line

SE/C

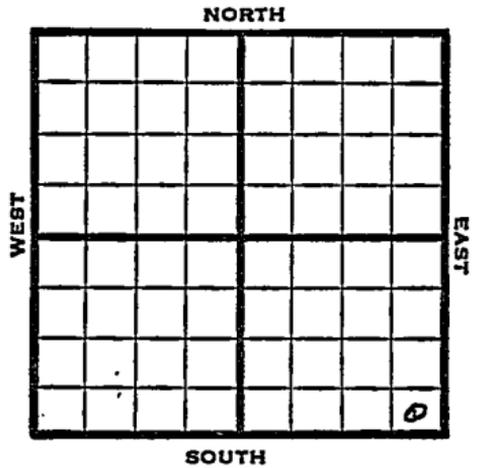

1948

Eli 1767'

REPORT

10/6

8" @ 327'

10/13

Drlg 3000'

10/19

Lansing 2889'
Simpson Shale 3201'
Arb. 3212'

TD 3213

5" @ 3213'

10/27

TD 3215'

Arb. 3212'

5" @ 3213'

Pump 63 oil / 16 W Pot
44° Gr.

Comp

COMPLETED

Map No. _____ Sec. 19 Twp. 17 R. 9W

Well No. 9 Wessler

Cities Service etal. Company

FIRST REPORT Contractor

SE/C

SECTION PLAT

_____ Ft. from N. Line

330 Ft. from S. Line

330 Ft. from E. Line

_____ Ft. from W. Line

Ellsworth County

Location _____

Rig up _____

Drilling and Remarks:

8" @ 327

RECORD

Cased _____ in., _____ ft.

Sand _____

Gas _____

Oil _____

Total Depth _____

PRODUCTION

1st 24 hrs. Nat. _____

1st 24 hrs. after shot _____

Gas _____ Cu. Ft.

Dry Hole _____

Abandoned _____

Date

OCT 6 1948 19

S. J. LEWIS Scout

Map No. 45 Sec. 19 Twp. 17 R. 9W
 Kansas

Well No. 9 Wessler

Cities Service etal. Company

COMPLETE

Contractor

SE/C

E. 1767

SECTION PLAT

330 Ft. from N. Line

330

Ft. from S. Line

330

Ft. from E. Line

Ft. from W. Line

Ellsworth County

RECORD

Location _____

Cased _____ in., _____ ft.

Rig up _____

Sand _____

Drilling and Remarks:

Gas _____

Per 43212

Oil

5" @ 3213

Total Depth 3215

Pump 63 oil + 16K
P.D.

PRODUCTION

1st 24 hrs. Nat. _____

1st 24 hrs. after shot _____

Gas _____ Cu. Ft.

Dry Hole _____

Abandoned _____

44 2/3

Date

OCT 27 1948 19

S. J. LEWIS Scout