


Section 19 Township 17 Range 10W

Well No. #1 Mathews(B)

Company Imperial Pet.

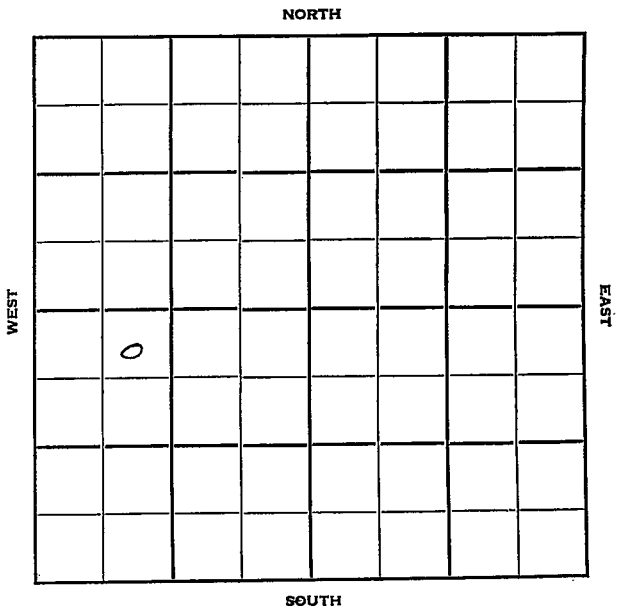

Sec. 19 Twp. 17 R. 10 W

Well No. # 1 Mathews (B) Farm

Imperial Pet. Company

Kraft Prusa Contractor


330 Ft. from N. Line

_____ Ft. from S. Line

_____ Ft. from E. Line

990 Ft. from W. Line

NE NW SW

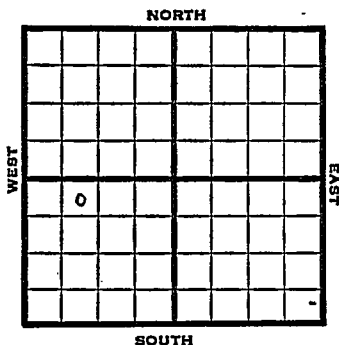

1951

Elev. 1839'

REPORT

10/10

RUR

12/19

Spud 10-10-51

D&A TD 3332

8" @ 233

Anhy 610

Heeb. 2876

Br. Li 2982

Lans. 3002

DST 3030-40 Rec. 15' mud

Cong. 3272

Arb. 3302

DST 3298-3305 open 1/2 hr. rec. 10' mud

DST 3305-10 open 1/2 hr. rec. 155'

oil 5" @ 3309 CO to 3315

1000 A wtr DD 3332 PB 3309

11/ 3306-08 300 A S/ 14 BWPB

D&A

ABANDONED

