


Section 19 Township 17 Range 10

Well No. #14 Peterman

Company Imperial Petroleum

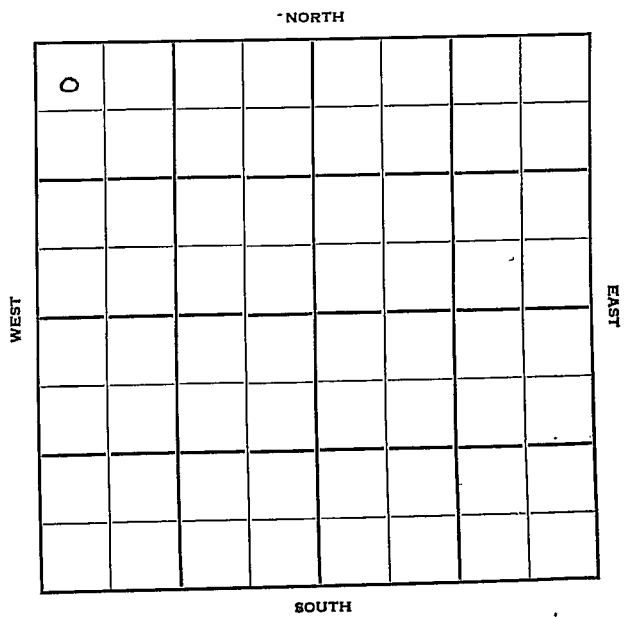

Ellsworth

KANSAS
10 W

Sec. 19 Twp. 17 R. 10 W

Well No. # 4 Peterman Farm

Imperial Petroleum Company

Kraft-Prusa Pool


330 Ft. from N. Line

Ft. from S. Line

Ft. from E. Line

330 Ft. from W. Line

NW NW NW

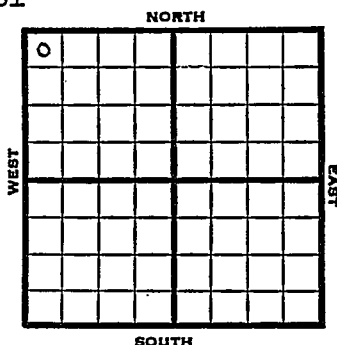

1951

Elev. 1854' REPORT

9/26

Location

11/7

Spud 9-26-51

Oil Well TD 3303

8" @ 212'

Anhy 620

Heeb. 2865

Br. 1m. 2971

Lans. 2991

DST 3175-3211 open 1 hr.

Rec. 480' oil

Cong. 3264

DST 3281-3304 open 1/2 hr.

Rec. 8' mud

Arb. 3298

DST 3298-3303 open 1 hr.

Rec. 275' oil TD 3303

5" @ 3298 CO to 3303

FU 2400' oil 16 hr.

S/ 7 BOPH 4 hr. 1500 A

S/ 26 BOPH

Comp. draw down pot. 1461 BOPD

COMPLETED

County Ellsworth State KansasSec. 19 (Blk.) 17 (Sur.) 10W Map No.Operator Imperial PetroleumWell No. 4 Farm PetermanElev. Location NW NW NW

0							

330 Ft. From N Line NW330 Ft. From W Line Quarter1st. Report SEP 26 1951

Completion

Remarks

Spudding Date

Drlg. Data

Kraft-Prusa Pool

Location

J. E. TYRA

County Ellsworth State KansasSec. 19 (Blk. Twp.) 17 (Sur. Rge.) 10W Map No.Operator Imperial PetroleumWell No. 4 Farm PetermanElev. 1854 Location NW NW NW

0							

330 Ft. From N Line NW

330 Ft. From W Line Quarter

1st. Report

NOV 7 1951

Completion

Remarks Kraft-Prusa PoolSpudding Date 9-26-51Drlg. Data Oil well TD 3303

8" @ 212 Anhy 620 Heeb. 2865

Br. lime 2971 Lans. 2991 DST 3175-3211

open 1 hr. Rec. 480' oil Cong. 3264

DST 3281-3304 open $\frac{1}{2}$ hr. Rec. 8' mud

Arb. 3298 DST 3298-3303 open 1 hr.

Rec. 275' oil TD 3303 5" @ 3298

CO to 3303 FU 2400' oil 16 hr.

S/ 7 boph 4 hr. 1500' A S/ 26 boph

Comp. draw down pot. 1461 bopd

J. E. TYRA