


Section 19 Township 17 Range 10-W

Well No. #1 Mathews

Company Polhamus & Howell
R. H. Shields

NORTH Stratman Pool

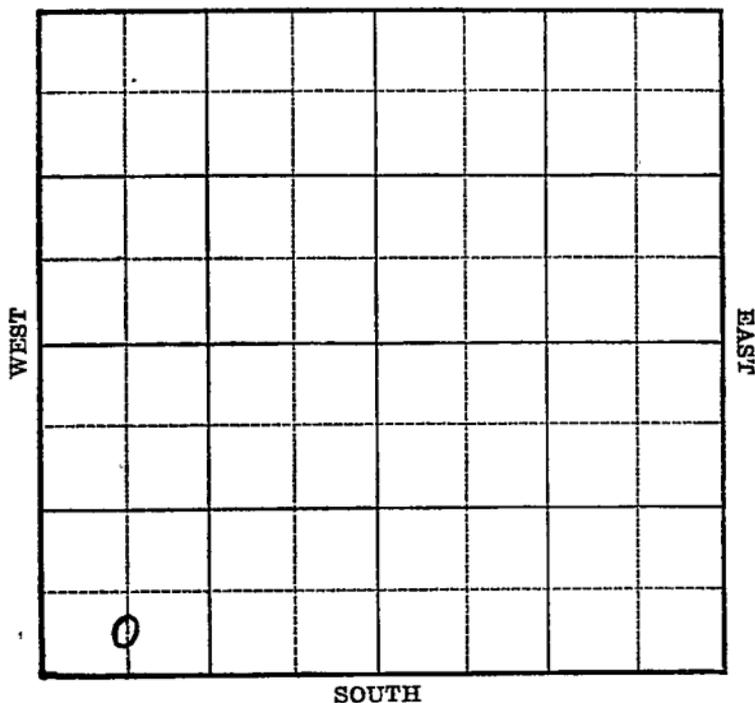

Sec. 19 Twp. 17 R. 10-W

Well No. #1 Mathews Farm
R. H. Shields Polhamus & Howell Company

(Stratman)


_____ Ft. from N. Line

330 Ft. from S. Line

_____ Ft. from E. Line

660 Ft. from W. Line

Elev. 1826

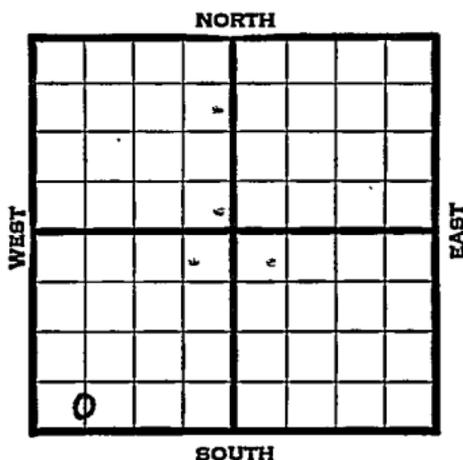

| 1939 | REPORT |
|------|---|
| 6/14 | Cable. |
| 6/23 | " |
| 6/29 | Rigging up. |
| 7/6 | RU & SD. |
| 7/13 | 15" - 260' Drlg. 540' |
| 7/20 | Anhy 590' 12" - 682' |
| | Drlg. 1220' |
| 7/27 | 1940' run 10". |
| 8/3 | Drlg. 2515' |
| 8/10 | 8" - 2995' Drlg. 3055' |
| 8/17 | Arb. 322 ³³¹⁵ 3307' T.D. 3283' |
| | 2850' oil 26 hours Run 7". |
| 8/24 | 7" - 3281' WOC. |
| 8/31 | Cong. 3281' Arb. 2725 ³³⁰⁷ ' (Correct. Pay 3281-84' in sand. T.D. 3317' SD. |
| 9/7 | 2500' water at 3317' T.D. P. B. 3304' 2000' oil in Gorham sand. Run tubing. |
| | OVER |

1939
9/14

Arb. 3307' (Corrected)
Estimated 30 bbls. per hour.

9/20

Arb. 3307'
7" - 3281'
T.D. 3317'
P. B. to 3304'
Sand 3281-84' Gorham
Potential 273 bbls., pump.

COMPLETED.

Map No. 55 Sec. 19 Twp. 17 R. 10W

Well No. 1 Mathews

R. H. Shields Company

Contractor

FIRST REPORT

SECTION PLAT

C S L SW SW

 Ft. from N. Line

330 Ft. from S. Line

 Ft. from E. Line

660 Ft. from W. Line

| | | | |
|--|--|--|--|
| | | | |
| | | | |
| | | | |
| | | | |

STRATMAN POOL

Location

Rig up

Drilling and Remarks:

Cable

RECORD

Cased in., ft.

Sand

Gas

Oil

Total Depth

PRODUCTION

1st 24 hrs. Nat.

1st 24 hrs. after shot

Gas Cu. Ft.

Dry Hole

Abandoned

Date

JUN 14 1939 19

S. J. LEWIS

Scout

Misc. Small Maps
Cards
Tracing
France Map
Scarborough Map
Moody Map
Geological Dept.
Moody Flat Book

Map No. 55 Sec. 19 Twp. 17 R. 10W

Well No. 1 Mathews

Polhamus & Howell Company

CORRECTION Contractor

SECTION PLAT

C S L SW SW

| | | | |
|--|--|--|--|
| | | | |
| | | | |
| | | | |
| | | | |

_____ Ft. from N. Line

330 Ft. from S. Line

_____ Ft. from E. Line

660 Ft. from W. Line

STRATMANN POOL

RECORD

Location _____

Cased _____ in., _____ ft.

Rig up _____

Sand _____

Drilling and Remarks:

Gas _____

Reported as:

Oil _____

R. H. Shields

Total Depth _____

PRODUCTION

1st 24 hrs. Nat. _____

1st 24 hrs. after shot _____

Gas _____ Cu. Ft.

Dry Hole _____

Abandoned _____

Date

AUG 16 1939

19

S. J. LEWIS Scout

Misc Small Maps
Cards
Tracing
France Map
Scarborough Map
Moody Map
Geological Dept.
Moody Flat Book

Handwritten signatures and initials:
- A large signature over "Misc Small Maps"
- "Cox" over "Tracing"
- "M.D." over "Scarborough Map"
- A checkmark over "Moody Map"

Ellsworth **KANSAS**Map No. _____ Sec. **19** Twp. **17** R. **10W**Well No. **1 Mathews****Polhamus & Howell** Company

Contractor

COMPLETED**C S L SW SW****SECTION PLAT**

_____ Ft. from N. Line

330 Ft. from S. Line

_____ Ft. from E. Line

660 Ft. from W. Line

| | | | |
|---|--|--|--|
| | | | |
| | | | |
| | | | |
| | | | |
| 0 | | | |

STRATMAN POOL

Location _____

RECORD

Cased _____ in., _____ ft.

Sand _____

Gas _____

Oil _____

Total Depth **3317****PRODUCTION**

1st 24 hrs. Nat. _____

1st 24 hrs. after shot _____

Gas _____ Cu. Ft.

Dry Hole _____

Abandoned _____

Rig up _____

Drilling and Remarks:

*Cr 3307**7" @ 3281**P.B 3304**Sand 3281-84 Polhamus**Pump 273 1/2*

Date

SEP 20 1939 19**S. J. LEWIS** Scout

114











| | |
|-----------------|--------------------|
| Misc Small Maps | <i>[Signature]</i> |
| Cards | <i>[Signature]</i> |
| Tracings | <i>[Signature]</i> |
| | <i>[Signature]</i> |
| | |
| | |
| | |