


Section 19 Township 17 Range 10 W

Well No. #4 Mathews

Company Imperial Oil

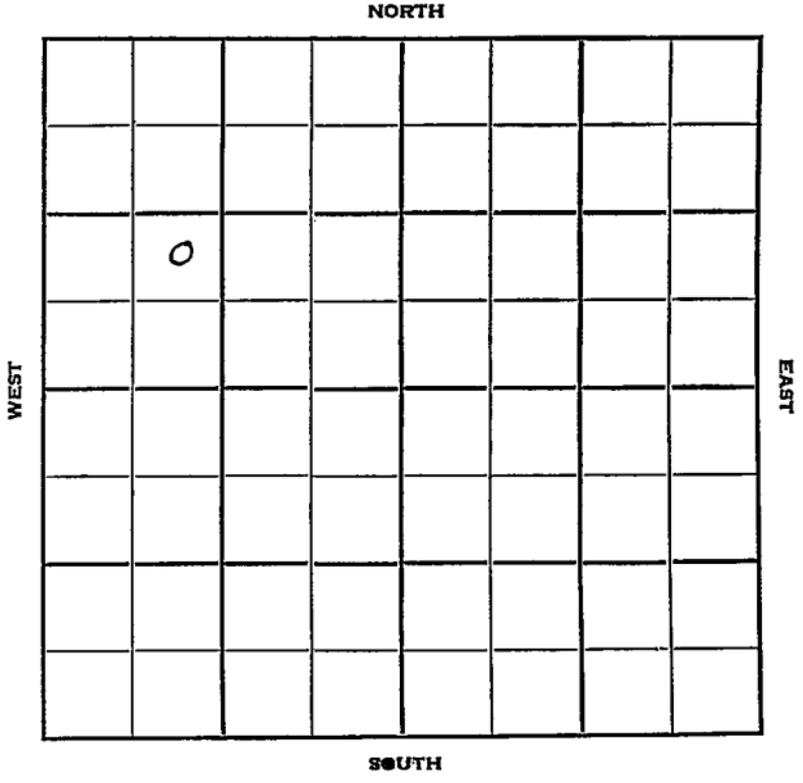

Sec. 19 Twp. 17 R. 10W

Well No. #4 Mathews Farm

Imperial Oil Company

K & E Drlg. -Contr. Contractor


\_\_\_\_\_ Ft. from N. Line

990' Ft. from S. Line

\_\_\_\_\_ Ft. from E. Line

990' Ft. from W. Line

NE SW NW

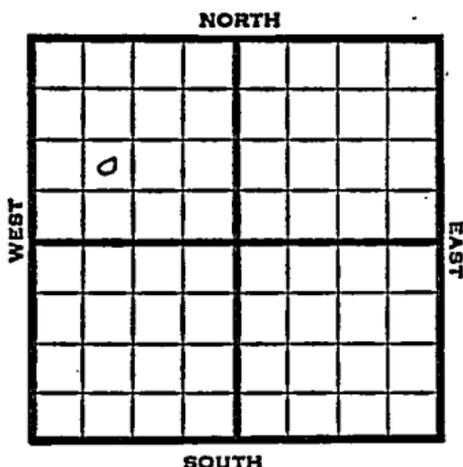

1951

Elev. 1845' REPORT

4/18

Spud 4-14-51  
8" @ 195  
Drlg. 1390'

5/23

Spud 4-14-51 Oil well TD 3322'  
8" @ 195 Heeb 2874' Br. line 2981'  
Lans. 2998' SO 3036-40' Arb. 3308'  
TD 3313' 5" @ 3310' S/2 BOPH  
500 A DD 3322' S/120 BO 20 BWPD  
Comp. 195 BOPD

**COMPLETED**



County Ellsworth State Kansas

Sec. 19 (Blk. Twp.) 17 (Sur. Rge.) 10W Map No.

Operator Imperial Oil

Well No. 4 Farm Mathews

Elev. 1845 Location NE SW NW

	o				
<b>COMPLETE</b>					

990Ft. From S Line NW

990Ft. From W Line Quarter

1st. Report

Completion MAY 23 1951

Remarks Mathews Pool

K & E Drlg. - Contr.

Spudding Date 4-14-51

Drlg. Data Oil well TD 3322

8" @ 195 Heeb. 2874 Br. lime 2981

Lans. 2998 SO 3036-40 Arb. 3308

TD 3313 5" @ 3310 S/ 2 boph 500 A

DD 3322 S/ 120 bo 20 bwpd

Comp. 195 bopd

J. E. TYRA