
FORM 51 25M 8-50 WESTERN KANSAS Ellsworth

Section 19 Township 17 Range 10-W

Well No. #1 Matthews

Company Imperial Oil

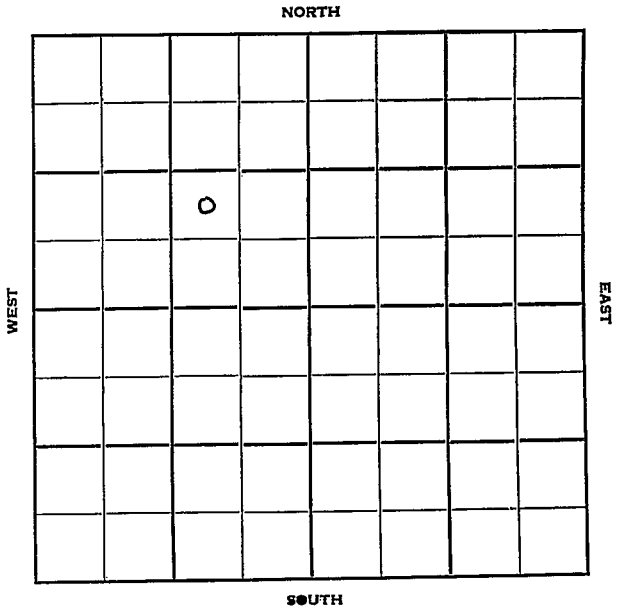

FORM 252-B
10M 11-50 PETROL

Ellsworth KANSAS

Sec. 19 Twp. 17 R. 10W

Well No. #1 Matthews Farm

Imperial Oil Company

B & B Drlg. - Contr. Contractor

Bloomers Pool


____ Ft. from N. Line

990' Ft. from S. Line

990' Ft. from E. Line

____ Ft. from W. Line

NW SE NW

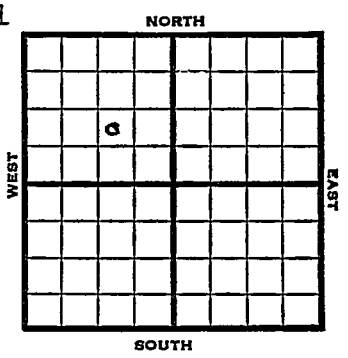

1951	Elv. 1841' REPORT
1/10 3/14	Location Oil Well TD 3085 8" @ 204 Anhy 615-40 Top 2750' Heeb. 2866 Doug 2894 Br Lime 2975 KC 2990 DST 3018-25 opn 20 min Rec. 30' gcm DST 3078-85 opn ½ hr gas in 7 min Rec. 1500' oil TD 3085 5" @ 3080' S/8 boph 1000 A S/35 boph FU 1200' oil 12 hr 800' wtr Comp. 1013 bopd 35% water COMPLETED

FORM 275 FOR SALE BY KANSAS BLUE PRINT CO.


County Ellsworth State Kansas

Sec. 19 (Blk. Twp.) 17 (Sur. Rge.) 10W Map No.

Operator Imperial Oil

Well No. 1 Farm Matthews

Elev. Location NW SE NW

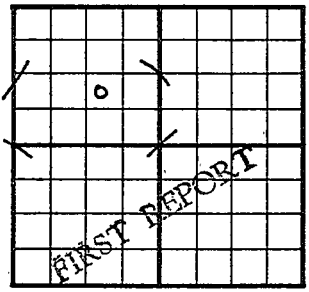

990 Ft. From S Line NW

990 Ft. From E Line Quarter

1st. Report JAN 1 0 1951

Completion

Remarks B & B Drlg. - Contr.

Spudding Date

Drlg. Data Bloomer Pool

Location

J. E. TYRA

FORM 275 FOR SALE BY KANSAS BLUE PRINT CO.


County Ellsworth State Kansas

Sec. 19 (Blk. Twp.) 17 (Sur. Rge.) 10W Map No.

Operator Imperial Oil

Well No. 1 Farm Matthews

Elev. 1841 Location NW SE NW

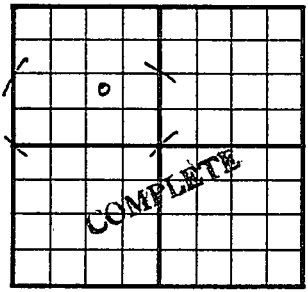

990 Ft. From S Line NW

990 Ft. From E Line Quarter

1st. Report

Completion MAR 1 4 1951

Remarks Bloomer Pool

B & B Drlg. - Contr.

Spudding Date

Drlg. Data Oil well TD 3085

8" @ 204 Anhy 615-40 Top. 2750

Heeb. 2866 Doug. 2894 Br. lime 2975

KC 2990 DST 3018-25 open 20 min.

Rec. 30' gcm DST 3078-85 open ½ hr.

Gas in 7 min. Rec. 1500' oil TD 3085

5" @ 3080 S/ 8 boph 1000 A S/ 35 boph

FU 1200' oil 12 hr. 800' water

Comp. 1013 bopd 34% water

J. E. TYRA