


Section 19 Township 17 Range 10 W

Well No. # 1 Stump

Company Okmar Oil

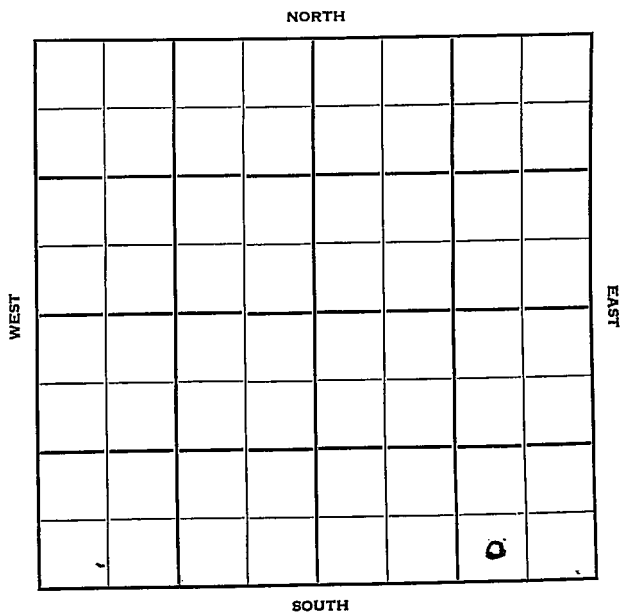

Sec. 19 Twp. 17 R. 10W

Well No. #1 Stump Farm

Okmar Oil Company

Contractor


Ft. from N. Line

330' Ft. from S. Line

990' Ft. from E. Line

Ft. from W. Line

SW SE SE

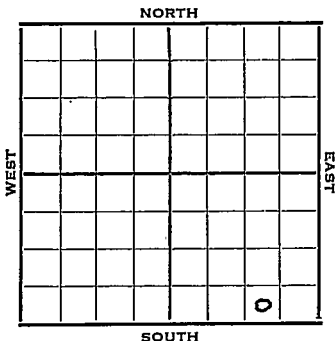

1952 Elev. 1818' REPORT

9/17 Spud 9-13-52
8" @ 215
Drlg. 1601

9/21 Drlg. 2793'

10/1 Spud 9-13-52
D & A TD 3331' 8" @ 215
Anhy 588' KC 2937' Cong. 3284'
Arb. 3288' TD 3331' D & A

ABANDONED

SEP 19 1952

Scout Cards	20
Land Small Map	
Land Wall Map	3
Tracings	
France Map	
Pierce Map	
Misc	

OCT 7 1952

Scout Cards	<i>mm</i>
Land Small Map	
Land Wall Map	<i>B</i>
Tracings	
France Map	
Pierce Map	
Misc.	

Orig. Data