


Section 19 Township 17 Range 10W

Well No. #1 Stumpf

Company Imperial Pet.

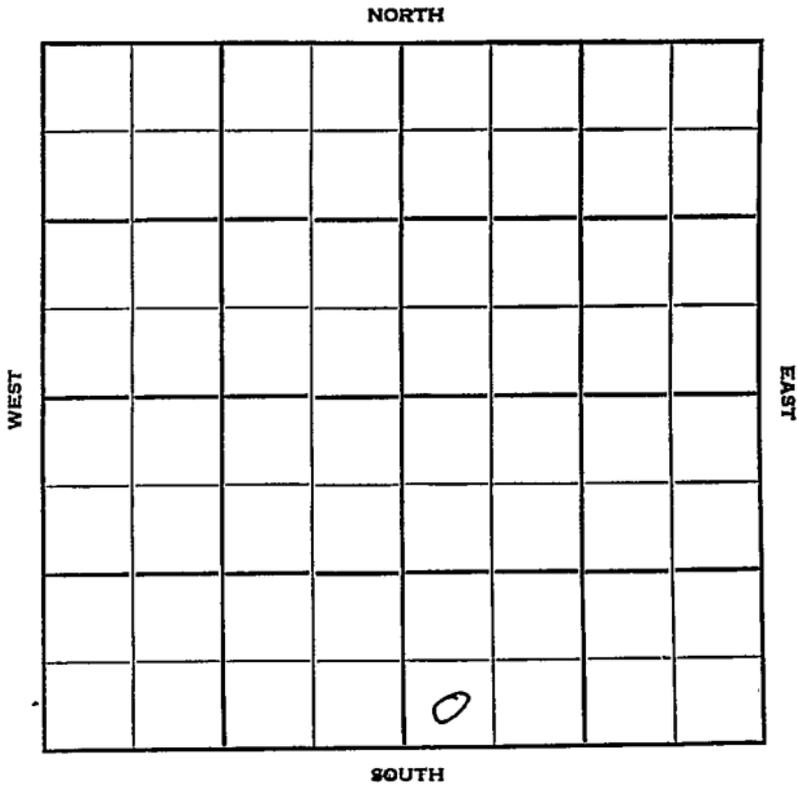

Sec. 19 Twp. 17 R. 10W

Well No. #1 Stumpf Farm _____

Imperial Pet. Company _____

Imperial Pet. Contractor _____
Kraft Prusa


_____ Ft. from N. Line

330 Ft. from S. Line

_____ Ft. from E. Line

330 Ft. from W. Line

SW SW SE

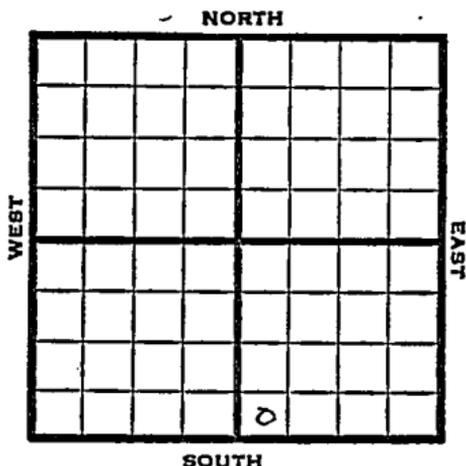

1951

Elev. 1824'

REPORT

11/14

RUR

1952

1/2

Spud 11-14-51

Oil Well

TD 3288

8" @ 220

Heeb. 2844

Lans. 2968

Cong. 3250

DST 3250-70 open 1/2 hr. rec. 8' mud

Arb. 3279

DST 3280-87 open 1 hr. rec. 10'

O&GCM 2' freeoil

5" @ 3280 TD 3288

S/ 6 GOPH 500 A

S/ 2 1/2 BOPH FU 1200' oil 12 hr.

Comp. 112 BOPD 3% wtr.

COMPLETED

