

Sec. 19 Twp. 17 R. 10W ✓

Well No. #1 Stumps "B" Farm

Imperial Drlg. Company

Contractor

Bloomer Pool


Ft. from N. Line

330' Ft. from S. Line

Ft. from E. Line

990' Ft. from W. Line

SE SW SE

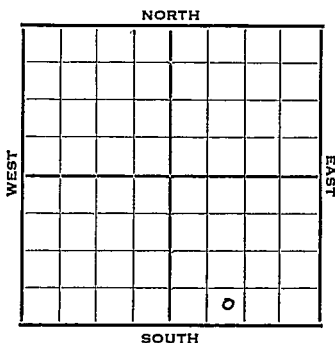

1952 Elev. 1814' REPORT

4/23 Spud 4-23-52
8" @ 162 WOC

4/30 Drlg. 2951 Anhy 575'

5/7 Heeb 2839' Br li 2944' Lans. 2966'
Arb. 3257'
DST 3258-66, 1 hr, 37' HOCM 340#
RTD 3266' 5" @ ? MICT

5/14 5" @ 3258 DP DD 3268 TD
8 galoph 1000 A Sq off to Re A

5/21 S/4 1/2 BOPH DD 3278' 1000 A
S/4 BOPH for 12 hrs. DD 3282'
2000 A S/7 1/2 BOPH for 4 hrs.
DD 3284' TD 1700' oil fill up 12 hrs.
tubing & rods.

5/28 POP

6/11 Spud 4-20-52 Oil Well TD 3284
8" @ 162 Anhy 575 Heeb. 2839
Br Lime 2944 Lans. 2966
Arb. 3257
DST 3258-66 opn 1 hr. Rec. 37' hocm
TD 3266 5" @ 3258 DD 3268 8 goph
1000 A 1000 A S/4 1/2 boph DD 3278
1000 A S/4 boph DD 3282 2000A
S/7 1/2 boph DD 3284 FU 1700' oil 12 hr
Comp. 240 bopd

COMPLETED

