


Section 19 Township 17 Range 10W

Well No. #2 Stumps (B)

Company Imperial

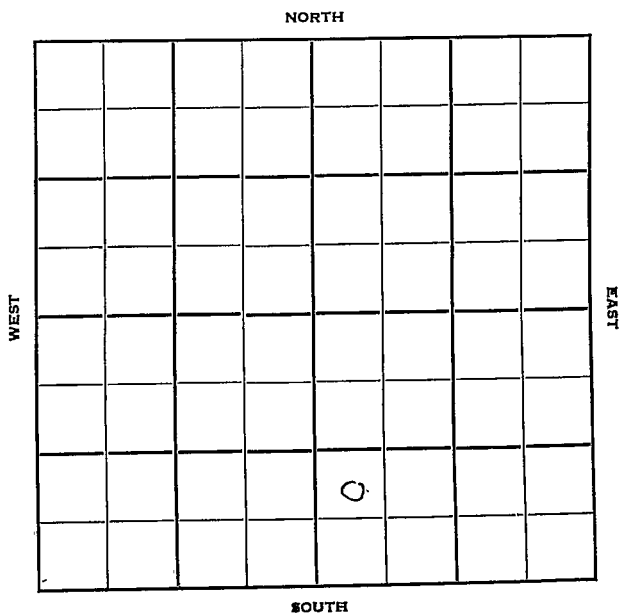

Ellsworth

KANSAS

Sec. 19 Twp. 17 R. 10W

Well No. #2 Stumps (B) Farm

Imperial Company

Imperial Contractor

Bloomer


Ft. from N. Line

990 Ft. from S. Line

Ft. from E. Line

330 Ft. from W. Line

NW SW SE

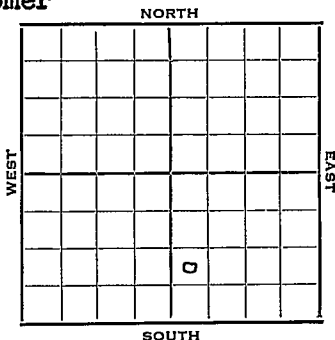

1952

Elev. 1826'

REPORT

- 5/7 Spud 5-2-52
8" @ 164'
Anhy 590'
Drlg. 1750'
- 5/14 Heeb. 2846 Br Li 2952 Lans. 2975
Cong. 3243 TD 3257 Twist off
Fishing
- 5/21 Spud 5-2-52 D&A TD 3320'
8" @ 164 Anhy 590' Heeb. 2846
Br Li 2952 Lans. 2975 Cong. 3243
Arb. 3314 TD 3320' D&A

ABANDONED

