


Section 19 Township 17 Range 9-W

Well No. #1 Splitter

Company Central Petroleum

NORTH **Schroeder Pool**

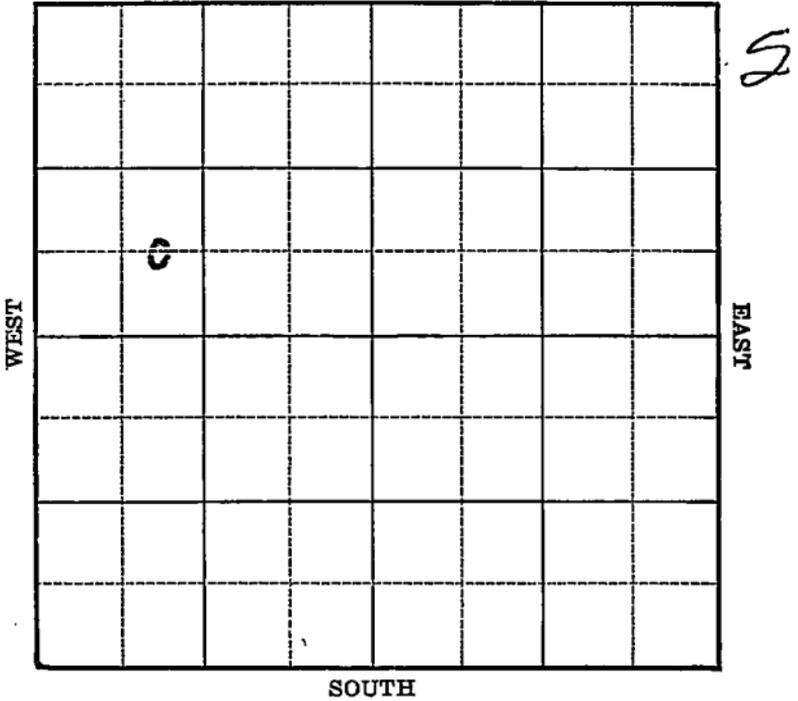

Sec. 19 Twp. 17 R. 9-W

Well No. #1 Splitter Farm

Central Petr.

Company

(Schroeder)


_____ Ft. from N. Line

660 Ft. from S. Line

_____ Ft. from E. Line

990 Ft. from W. Line

Elev. 1791

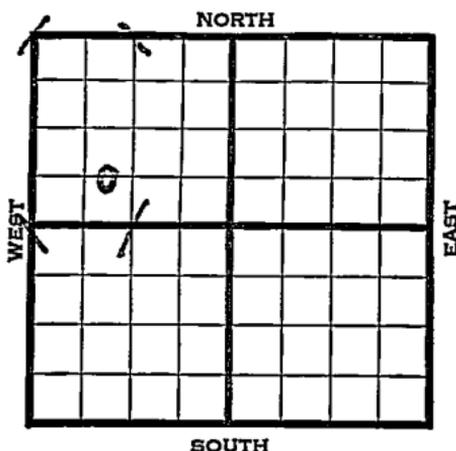

1941

REPORT

3/5 8" - 198' WOC.

3/13 Drlg. 2700'

3/19 Arb. 3249'

T.D. 3277'

No shows.

ABANDONED

Map No. 45 Sec. 19 Twp. 17 R. 9W

Well No. 1 Splitter

Central Petroleum Company

FIRST REPORT Contractor

SECTION PLAT


C E L SW NW

 Ft. from N. Line

660 Ft. from S. Line

 Ft. from E. Line

990 Ft. from W. Line

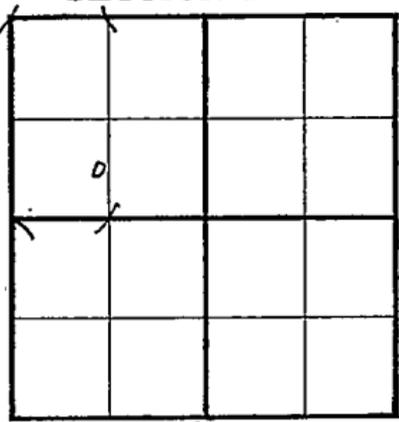

SCHROEDER POOL

Location

Rig up

Drilling and Remarks:

8" - 198 WOC

RECORD

Cased in., ft.

Sand

Gas

Oil

Total Depth

PRODUCTION

1st 24 hrs. Nat.

1st 24 hrs. after shot

Gas Cu. Ft.

Dry Hole

Abandoned

Date

MAR 5 ~~1914~~ 1914

S. J. LEWIS Scout

Map No. 45 Sec. 19 Twp. 17 R. 9WWell No. 1 SplitterCentral Petroleum Company

Contractor

ABANDONED**SECTION PLAT**

C E L S W N W

 Ft. from N. Line660 Ft. from S. Line Ft. from E. Line990 Ft. from W. Line

SCHROEDER POOL

Location Rig up

Drilling and Remarks:

*Ar 3249**Noe hood***RECORD**Cased in., ft.Sand Gas Oil Total Depth 3227**PRODUCTION**1st 24 hrs. Nat. 1st 24 hrs. after shot Gas Cu. Ft.Dry Hole Abandoned

Date

MAR 19 1941 19

S. J. LEWIS Scout