

KANSAS


Form 51—5M—7-39—Palace

Ellsworth

Section 19 Township 17 Range 9-W

Well No. #2 Wessler

Company Cities Service Oil

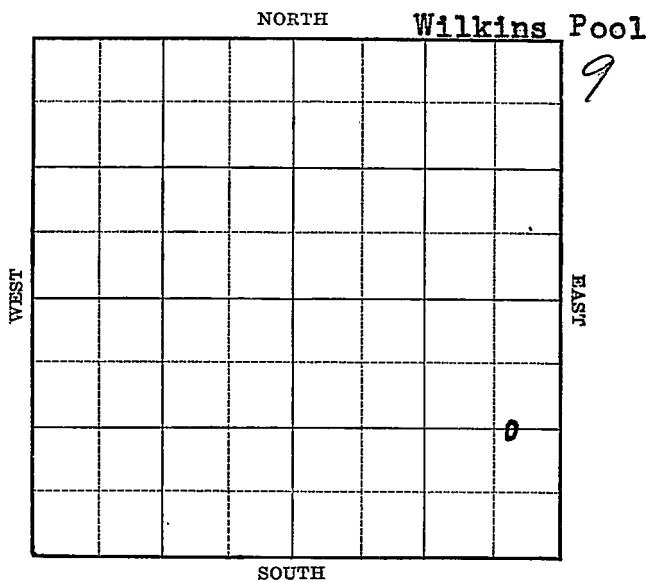

Map No. 45 Sec. 19 Twp. 17 R. 9WWell No. 2 WesslerCities Service Oil

Company

Contractor

FIRST REPORT**SECTION PLAT**1320 C E L S E
Ft. from N. Line

Ft. from S. Line

440 Ft. from E. Line

Ft. from W. Line

WILKINS POOL

Location _____

Rig up _____

Drilling and Remarks:

8 5/8" - 212WOC**RECORD**

Cased _____ in., _____ ft.

Sand _____

Gas _____

Oil _____

Total Depth _____

PRODUCTION

1st 24 hrs. Nat. _____

1st 24 hrs. after shot _____

Gas _____ Cu. Ft.

Dry Hole _____

Abandoned _____

Date

JAN 31 1940 19S. J. LEWIS Scout

Map No. 45 Sec. 19 Twp. 17 R. 9WWell No. 2 Wessler

Cities Service Oil

Company

Contractor

COMPLETED

C E L S E

1320 Ft. from N. Line Ft. from S. Line440 Ft. from E. Line Ft. from W. Line**SECTION PLAT**

WILKINS POOL

Location Rig up

Drilling and Remarks:

*On 8 3220.**5" 3221**2000 acid**Echometer P & S**2/63***RECORD**Cased in., ft.Sand Gas Oil Total Depth 3228**PRODUCTION**1st 24 hrs. Nat. 1st 24 hrs. after shot Gas Cu. Ft.Dry Hole Abandoned

Date

FEB 23 1940 19

S. J. LEWIS

Scout