

KANSAS

Ellsworth

Section 19 Township 17 Range 9WWell No. #7 WesslerCompany Cities Service etal

NORTH

16

						9	

SOUTH

WEST

EAST

KANSAS

Ellsworth

Sec. 19 Twp. 17 R. 9W

Well No. #7 Wessler Farm

Cities Service et al

Company

Stoltenberg Pool

Ft. from N. Line

330'


Ft. from S. Line

990'

Ft. from E. Line

Ft. from W. Line

SW SE SE

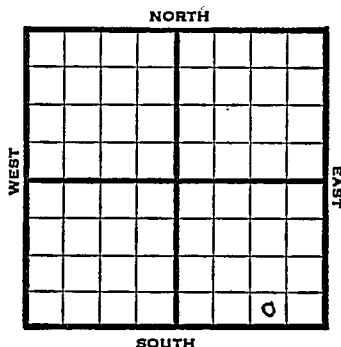

1948

Elev. 1772' REPORT

2/4

8" @ 254'

Drlg. 1705'

2/11

Arbuckle 3208-12' TD

5" @ 3210'

RUST

2/18

"

2/25

3212- 3206

Lansing 2888'

Arbuckle 3202'

5" @ 3204'

TD 3221'

500 Acid

Pump 17 bbls oil PH 6 hrs.

3/3

Arbuckle 3202'

5" @ 3204'

500 Acid

Pump 664 Pot.

Gr. 49°

Total Depth 3221'

COMPLETED

Map No. _____ Sec. 19 Twp. 17 R. 9W

Well No. 7 Wessler

Cities Service etal. Company

FIRST REPORT Contractor

SW SE SE


SECTION PLAT

_____ Ft. from N. Line

330 Ft. from S. Line

990 Ft. from E. Line

_____ Ft. from W. Line

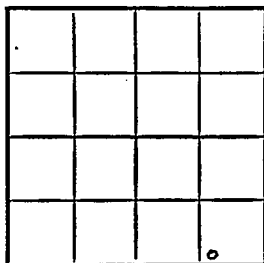

Ellsworth County

Location _____

Rig up _____

Drilling and Remarks:

8" @ 254

drlg. 1705

RECORD

Cased _____ in., _____ ft.

Sand _____

Gas _____

Oil _____

Total Depth _____

PRODUCTION

1st 24 hrs. Nat. _____

1st 24 hrs. after shot _____

Gas _____ Cu. Ft.

Dry Hole _____

Abandoned _____

Date

FEB 4 1948

19

S. J. LEWIS Scout

Map No. 45 Sec. 19 Twp. 17 R. 9W

Well No. 7 Wessler

Cities Service etal. Company

COMPLETE

Contractor

SW SE SE 33-34-35

E11772

SECTION PLAT

 Ft. from N. Line

330 Ft. from S. Line

990 Ft. from E. Line

 Ft. from W. Line

			6

Ellsworth County

Location

Rig up

Drilling and Remarks:

Cr 8202

5" C 3204

500000

Pump 664

49-84

RECORD

Cased in., ft.

Sand

Gas

Oil ✓

Total Depth 3221

PRODUCTION

1st 24 hrs. Nat.

1st 24 hrs. after shot

Gas Cu. Ft.

Dry Hole

Abandoned

Date

MAR 3 1948

19

S. J. LEWIS

Scout