

McPherson


FORM 51 5M RE-201

KANSAS

Section 19 Township 17 Range 3W

Well No. #2, Landers

Company Dickey

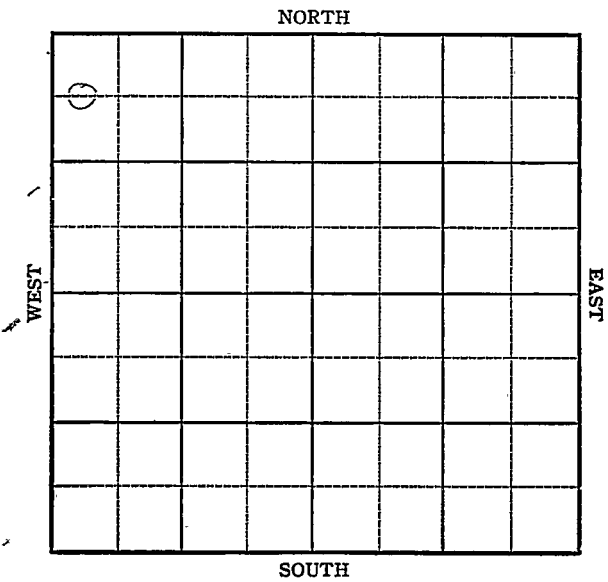

Sec. 19 Twp. 17 R. 3W

Well No. #2 Landers Farm

Dickey Company

Lindsborg


NORTH

660 Ft. from N. Line

 Ft. from S. Line

 Ft. from E. Line

330 Ft. from W. Line

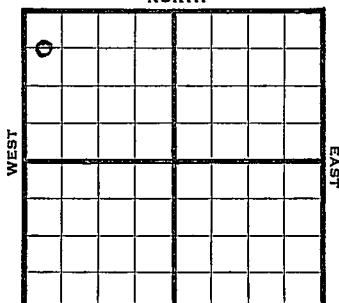

Elev. 1350

1944

REPORT

5/24 Location

5/31 Rotary

6/7 12" @ 71'
8" @ 350
Drlg. 990'

6/15 Drlg. 2900'

6/21 Misener 3370
Viola 3420
Sat 3395
TD 3437
Run Csg.

6/28 TD 3435
5" @ 3422 RUST

7/12 " " " "


7/19 TD 3463 Water Plug 3420
79 shots 3386-98 500 acid

7/26 Viola 3420
5" @ 3432
3500 acid
Pump 30 Pot.
Grav. 36.
TD 3463

COMPLETED

KANSASPool Name LindsborgMap No. 42 Sec. 19 Twp. 17 R. 3WWell No. 2 LandersDickey Company**FIRST REPORT**

Contractor

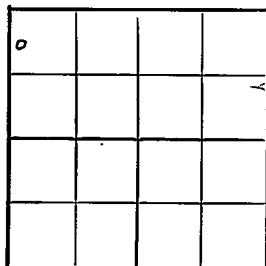C W L NW NW**SECTION PLAT**660 Ft. from N. Line Ft. from S. Line Ft. from E. Line330 Ft. from W. LineMcPherson CountyLocation XRig up

Drilling and Remarks:

RECORDCased in., ft.Sand Gas Oil Total Depth **PRODUCTION**1st 24 hrs. Nat. 1st 24 hrs. after shot Gas Cu. Ft.Dry Hole Abandoned

Date

MAY 24 194419S. J. LEWIS Scout

Pool Name LindsborgMap No. KANSAS Sec. 19 Twp. 17 R. 3WWell No. 2 LandersDickey CompanyCOMPLETED Contractor

C W L NW NW

SECTION PLAT

0			

660 Ft. from N. Line Ft. from S. Line Ft. from E. Line330 Ft. from W. LineMcPherson CountyLocation Rig up

Drilling and Remarks:

*Viola 3420**5" C 3432**3500 acal**Pump 30 B X**3634*

RECORD

Cased in., ft.Sand Gas Oil Total Depth 3463

PRODUCTION

1st 24 hrs. Nat. 1st 24 hrs. after shot Gas Cu. Ft.Dry Hole Abandoned

Date

JUL 26 1944 19S. J. LEWIS Scout